

# PLAT OF SURVEY

OF PROPERTY OF John Lichte


DESCRIBED AS FOLLOWS Lot 8, Block 6, Skidmore's Addition

SCALE: 1 INCH = 30 FEET

T. J. WELCH, REGISTERED SURVEYOR  
738 SURREY AVENUE, ST. PAUL 6, MINN.

o DENOTES IRON

EAST 4<sup>TH</sup> ST.

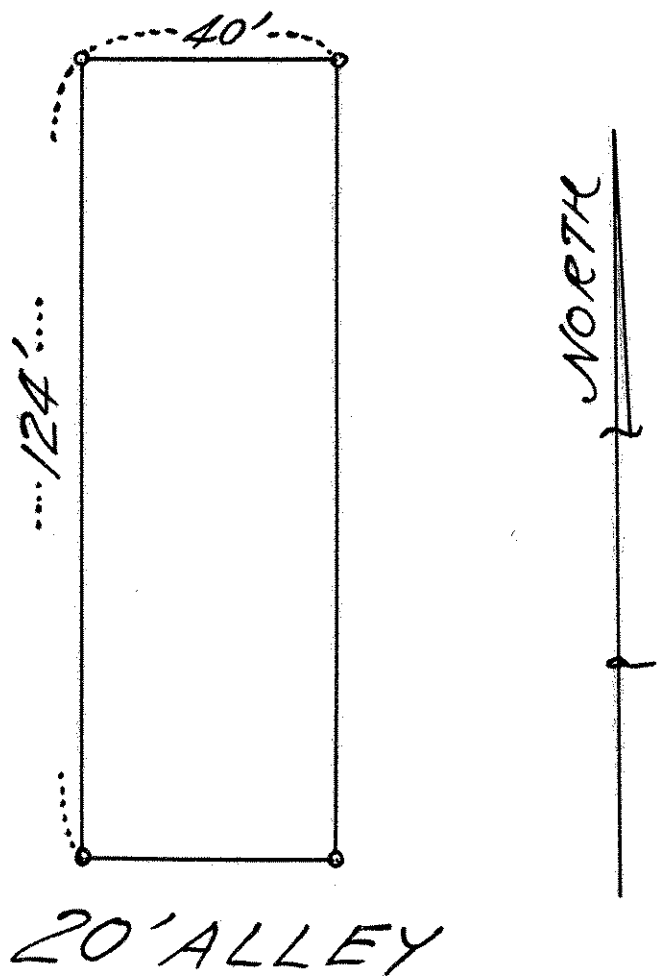

### CERTIFICATE OF SURVEY

I hereby certify that on 6-11 19 59  
I surveyed the property described above and that the above  
plat is a correct representation of said survey.

J. J. Welch