

Appl. 29379

PR6-0640
TELEPHONE TOWER 0640

PLAT OF SURVEY

OF PROPERTY OF Matthew A. Christenson



DESCRIBED AS FOLLOWS Lot 2 Block 6 Skidmore Addition

No 1092 ~ East 4th Street, St. Paul, Minn.

SCALE: 1 INCH = 30 FEET

T. J. WELCH, REGISTERED SURVEYOR
738 SURREY AVENUE, ST. PAUL 6, MINN.

EAST 4TH STREET

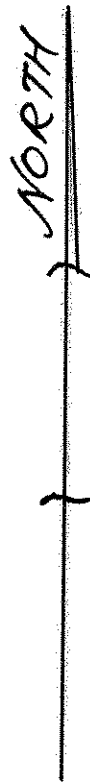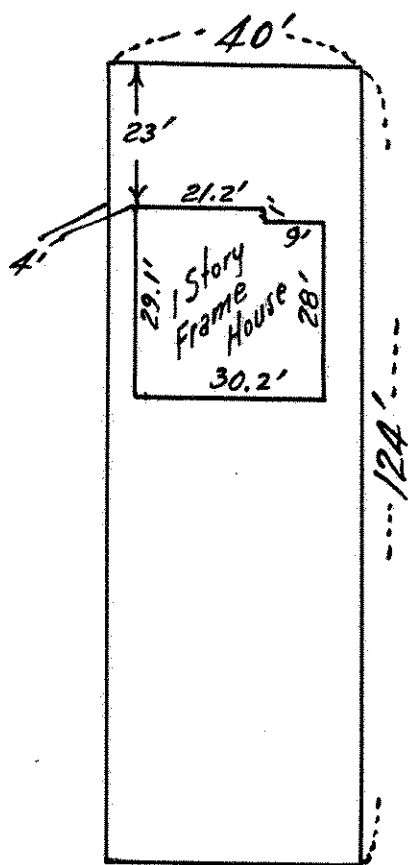

20' ALLEY

CERTIFICATE OF SURVEY

I hereby certify that on 5-16 19 59

I surveyed the property described above and that the above plat is a correct representation of said survey.

J. J. Welch