

PLAT OF SURVEY

2


OF PROPERTY OF _____

DESCRIBED AS FOLLOWS Lot 6, Block 4, Skidmore's Addition

SCALE: 1 INCH 30 FEET
o Indicates Iron.

T. J. WELCH, REGISTERED SURVEYOR
738 SURREY AVENUE, ST. PAUL 6, MINN.

E. FOURTH ST.

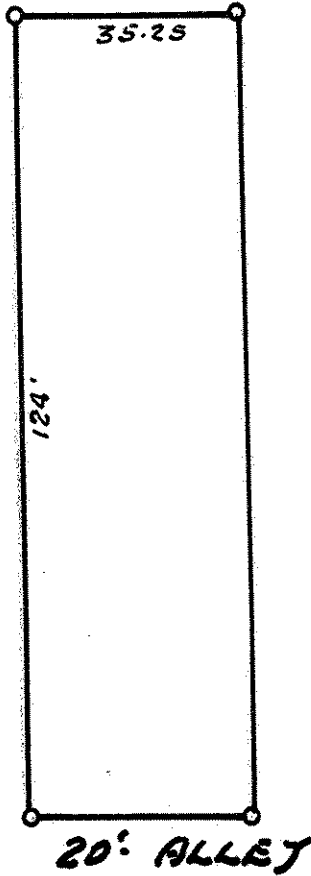

Handwritten vertical text:
S
r

CERTIFICATE OF SURVEY

I hereby certify that on 7-17 1952.

I surveyed the property described above and that the above plat is a correct representation of said survey.

T. J. Welch