

PLAT OF SURVEY


OF PROPERTY OF J. Vievering

DESCRIBED AS FOLLOWS Lot 4, Block 3, Skidmore's Addition

Plat 54

SCALE: 1 INCH = 40 FEET
O DENOTES IRON

T. J. WELCH, REGISTERED SURVEYOR
738 SURREY AVENUE, ST. PAUL 6, MINN.

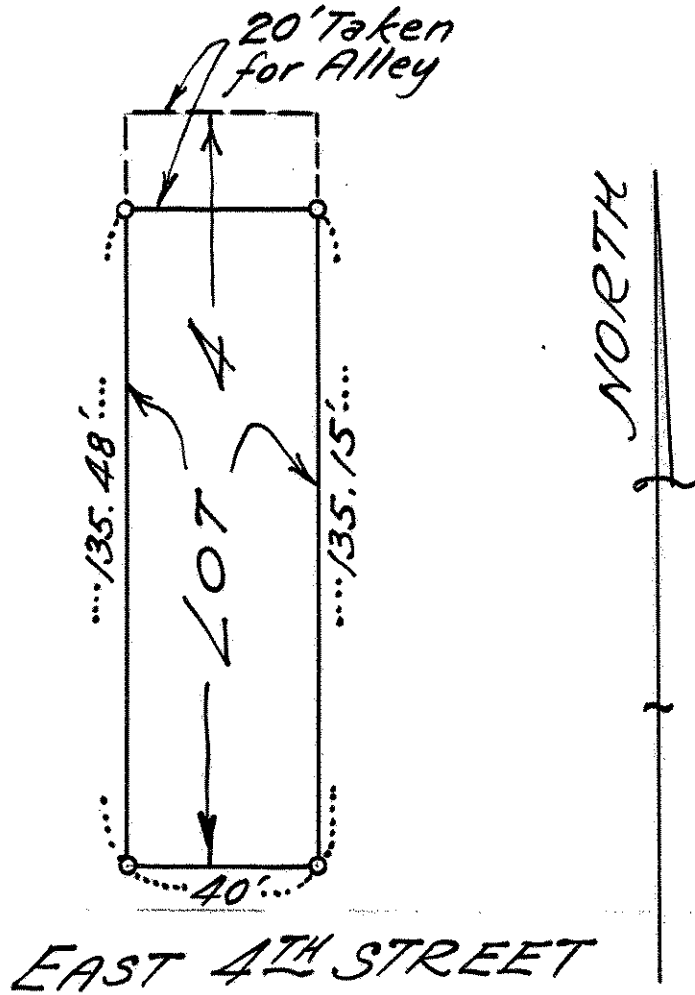

CERTIFICATE OF SURVEY

I hereby certify that on 9-28, 1960
I surveyed the property described above and that the above
plat is a correct representation of said survey.

T. J. Welch