

LOT 28 BLOCK 3
LOT 1 BLOCK 6

SKIDMORE & CASSIDY'S

PARK ADD.


JOHN B. IRVINE SURVEYOR.

SCALE 20ft per inch.

JUNE 30-09.

SELBY AVE.

IRON

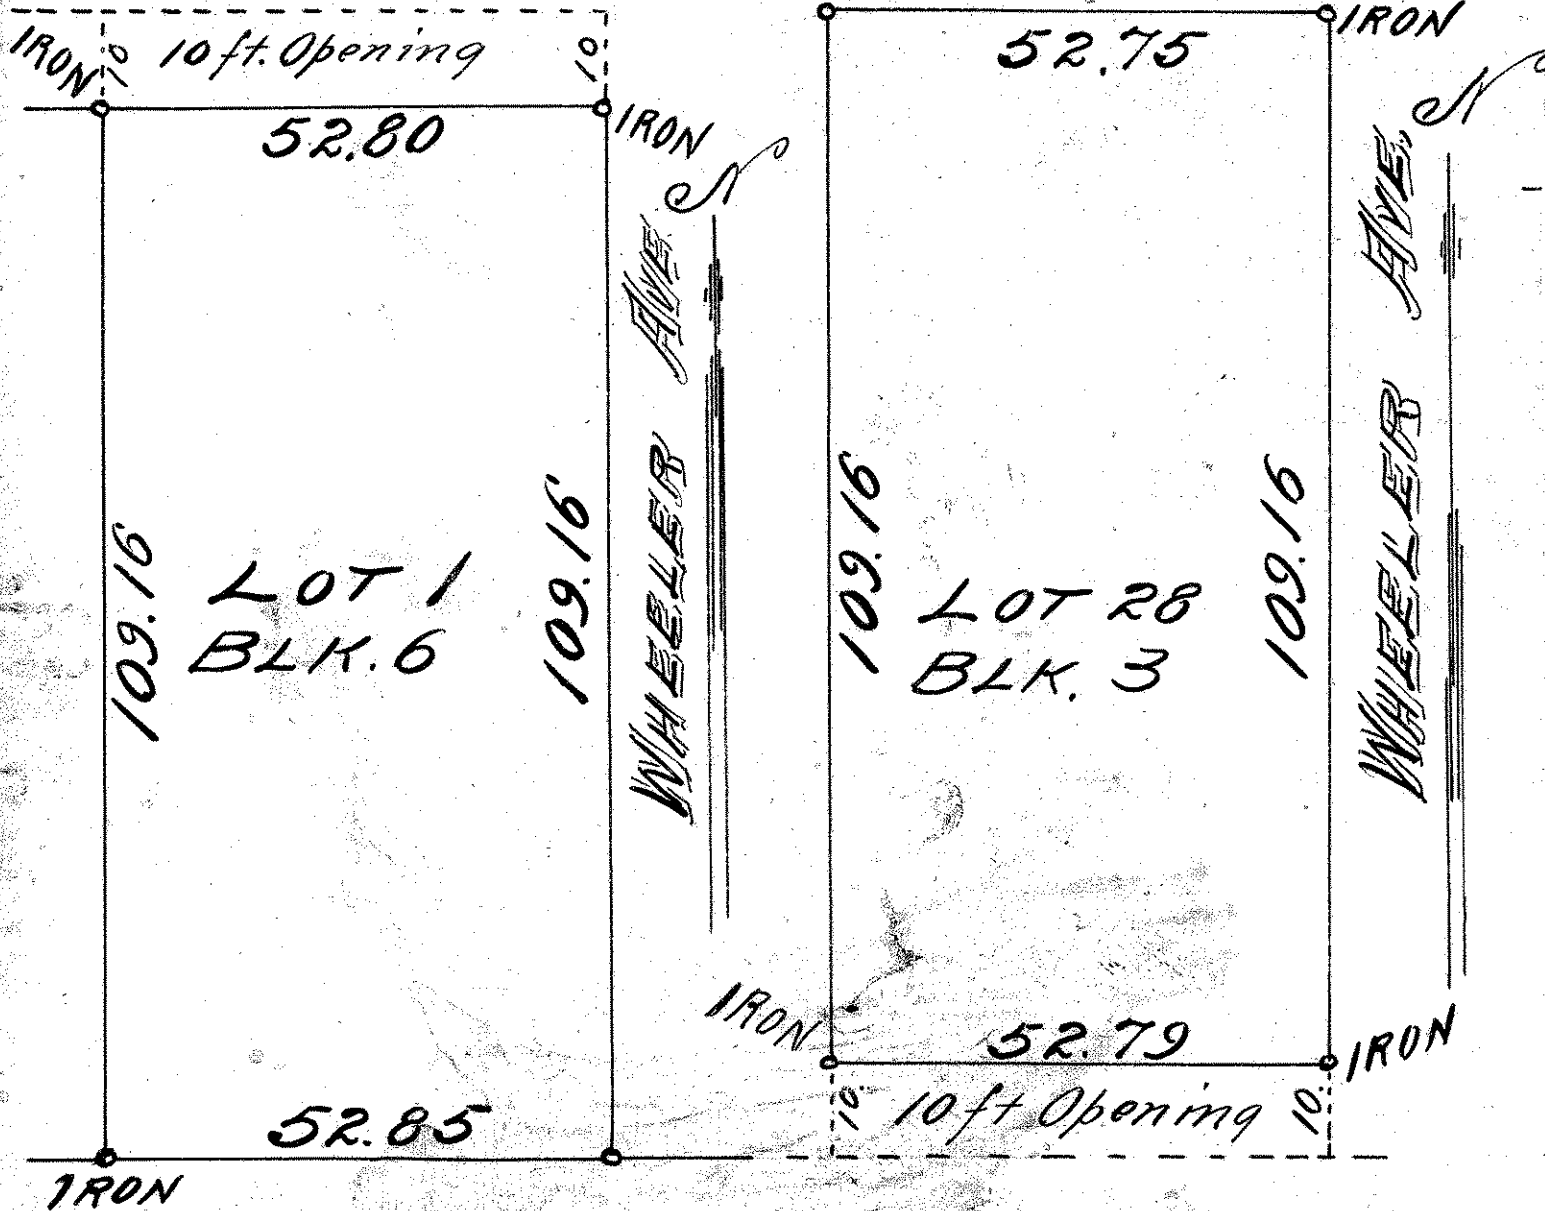

SELBY AVE.