

LOT 13 BLOCK 2.

SKIDMORE & CASSEY

PARK ADD.

JOHN B. IRVINE, SURVEYOR.

408 GLOBE BLDG.

ST. PAUL, MINN.

JUNE 30-1911.


SCALE 20 ft. per inch.

shortage

Marshall Ave. 3.39

Dayton Ave. 2.88

MARSHALL AVE.

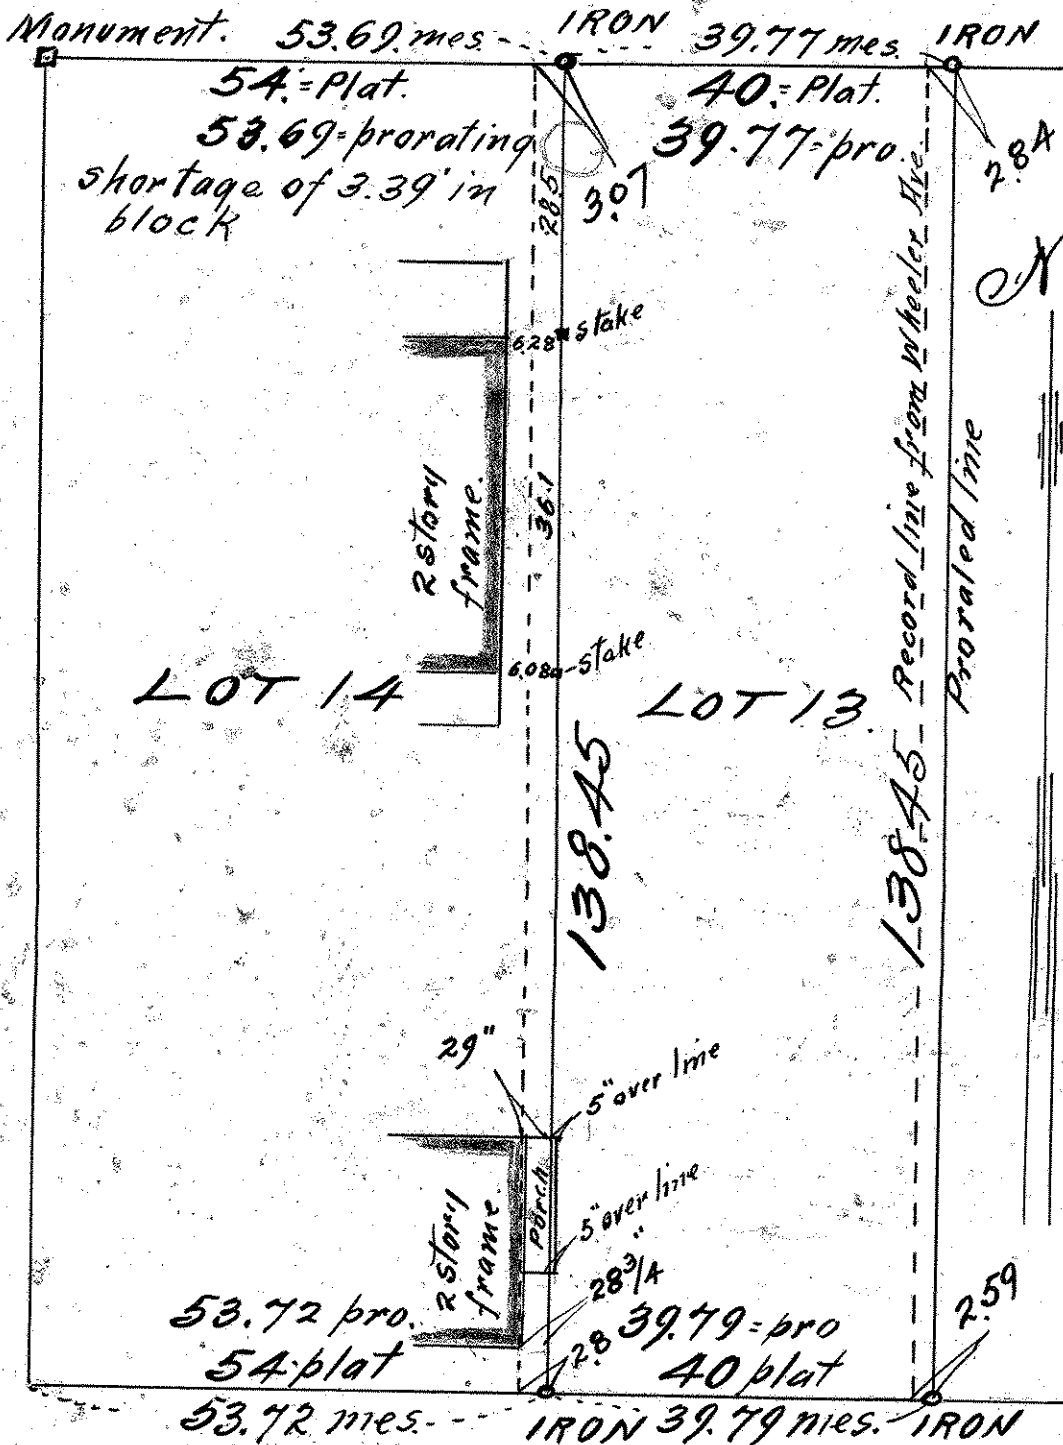

FAIRVIEW AVE.

ALLEY 20.