

LOTS 15 TO 28 INCLUSIVE BLOCK 6.

SKIDMORE & CASSIDY'S

PARK ADD.

SCALE 50ft. per inch.

○ INDICATES IRONS

JOHN B. IRVINE, SURVEYOR.

416 GLOBE BLDG.

ST PAUL MINN.


DEC 12-06

MAY 11-09

80. SELBY AVE.

66 FAIRVIEW AVE.

66 WHEELER AVE.

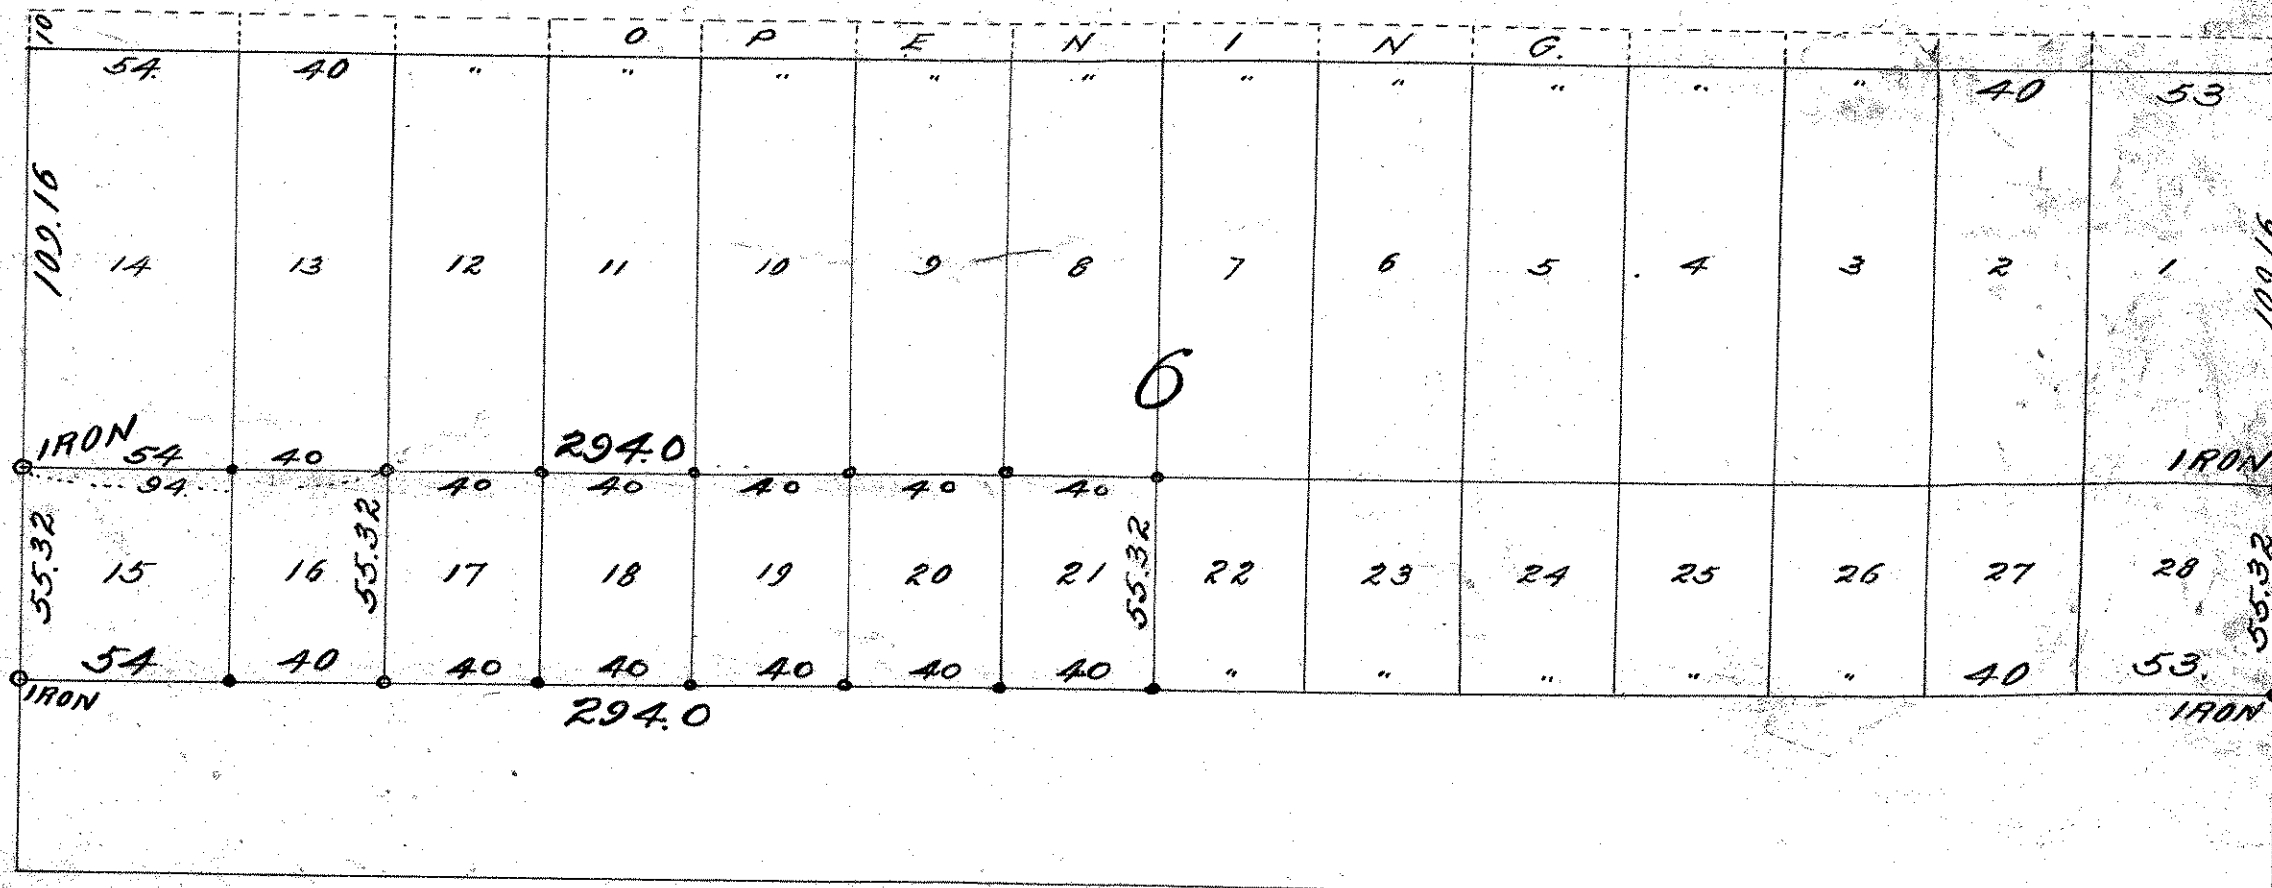

HAGUE AVE. 60.