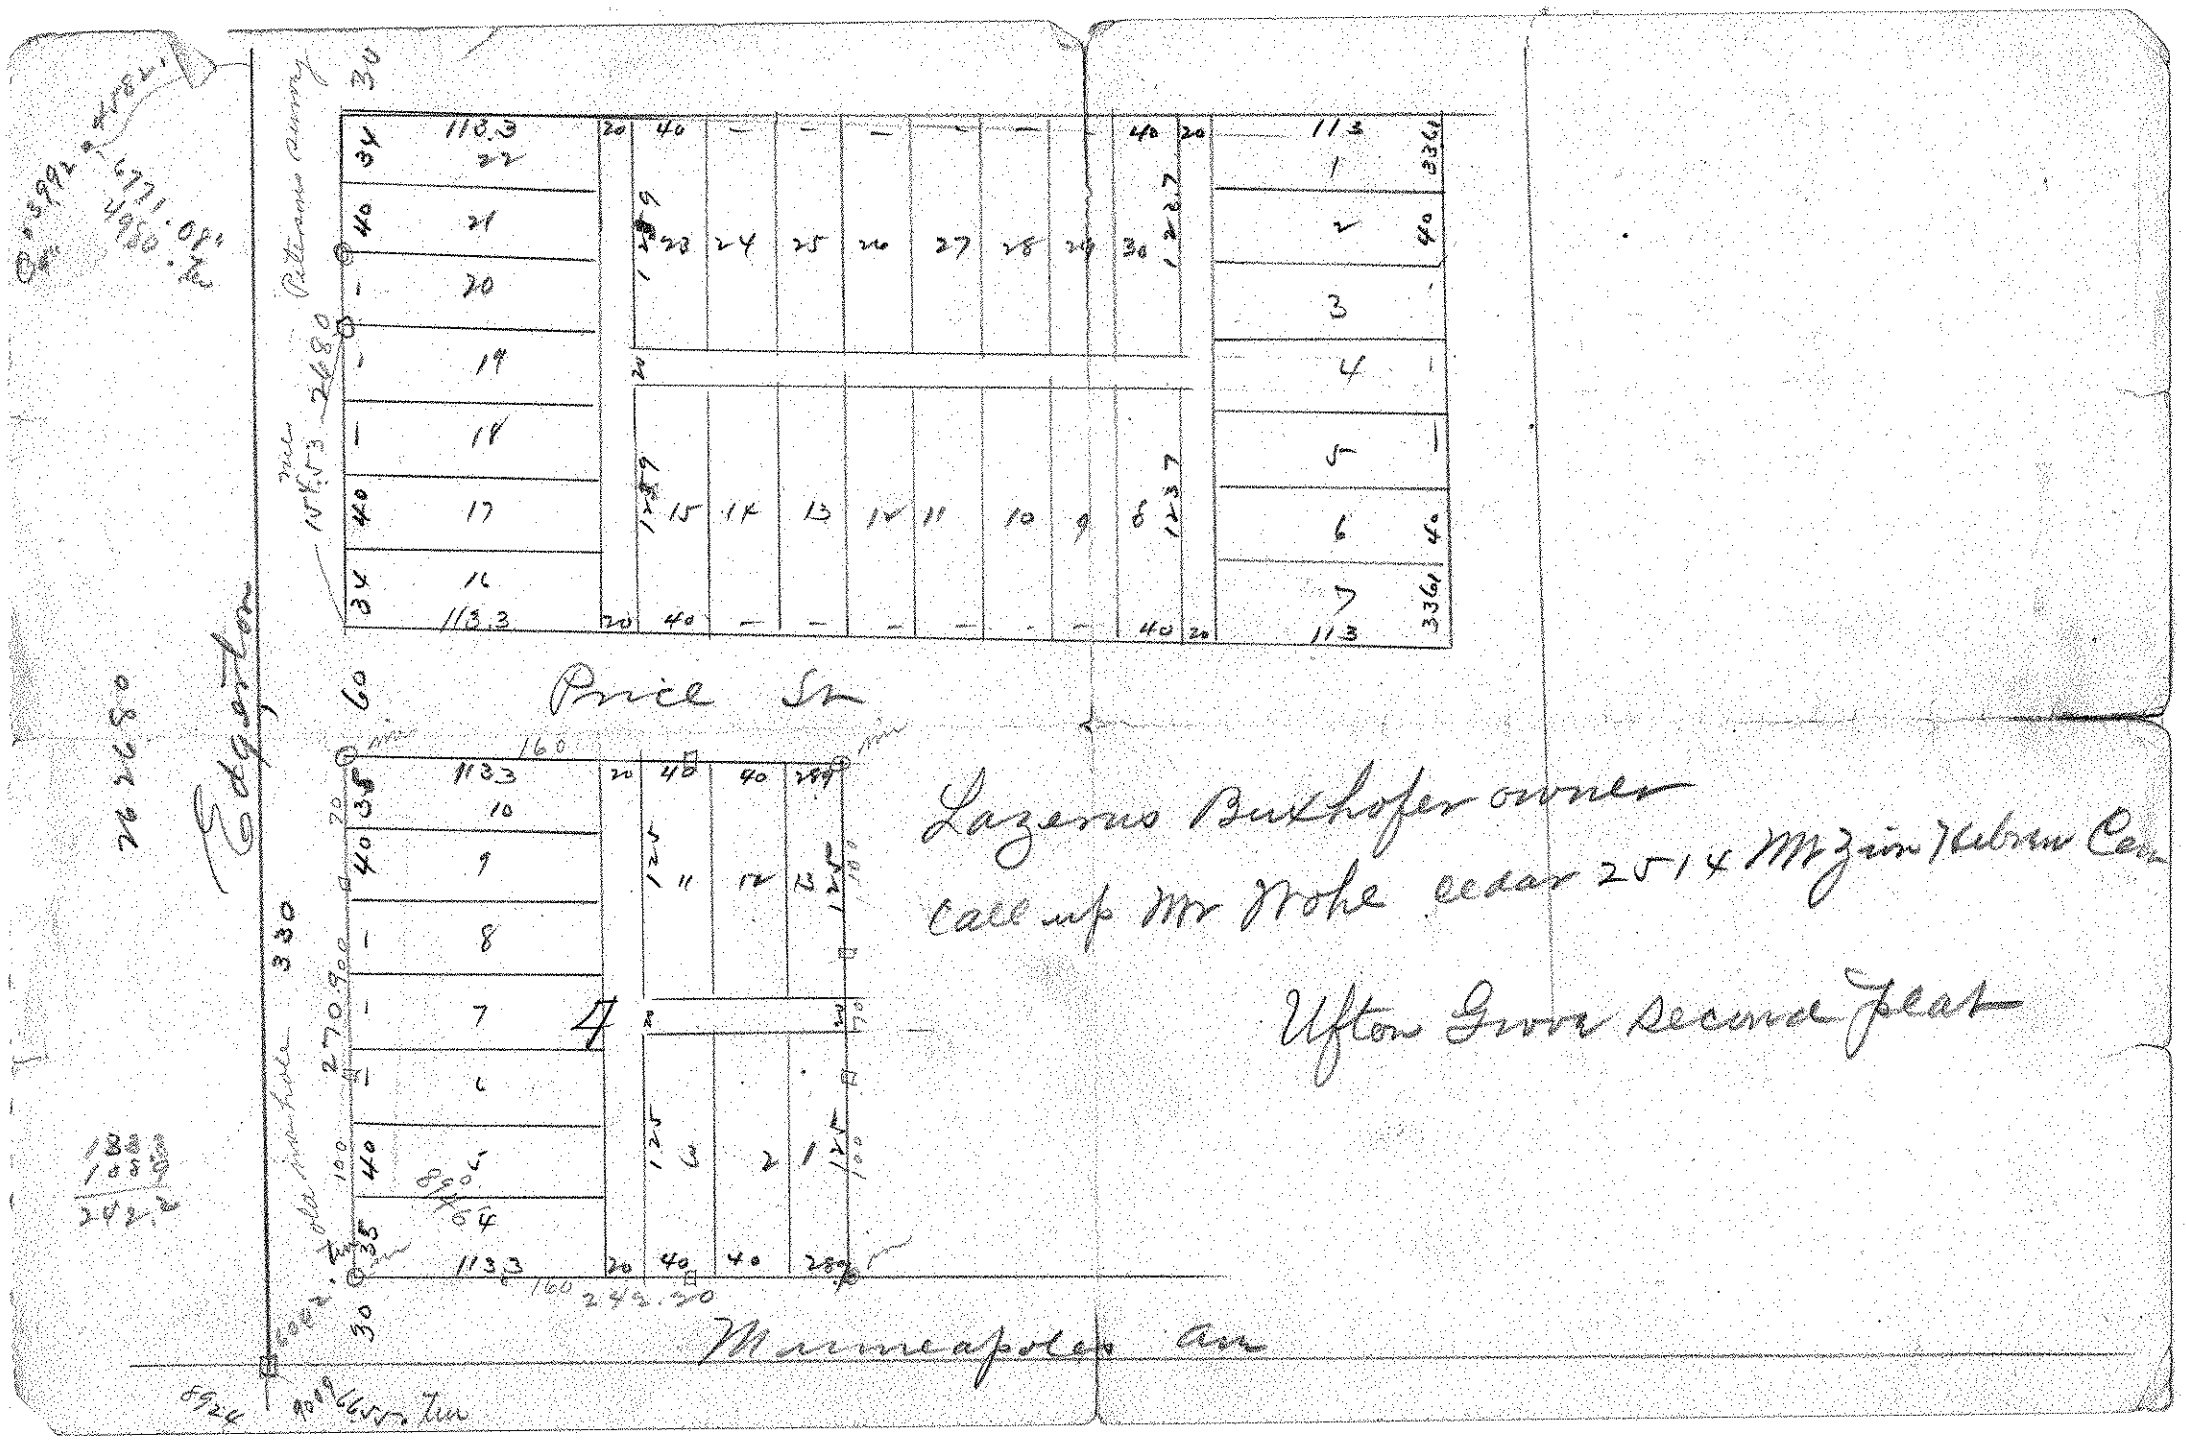
Price St
Edgerton
Minneapolis Av
Lazerus Buxhofer owner
Call up Mr Wohl cedar 2514 Mt Zion Hebrew Cem
Ufton Grove Second Plat