

LOT 4 BLOCK 1.


UNDERWOOD'S 1ST ADD.

John B. Irvine, Surveyor.

May 20, 1921.

Scale 20 ft. per inch.

GOODRICH AVE.

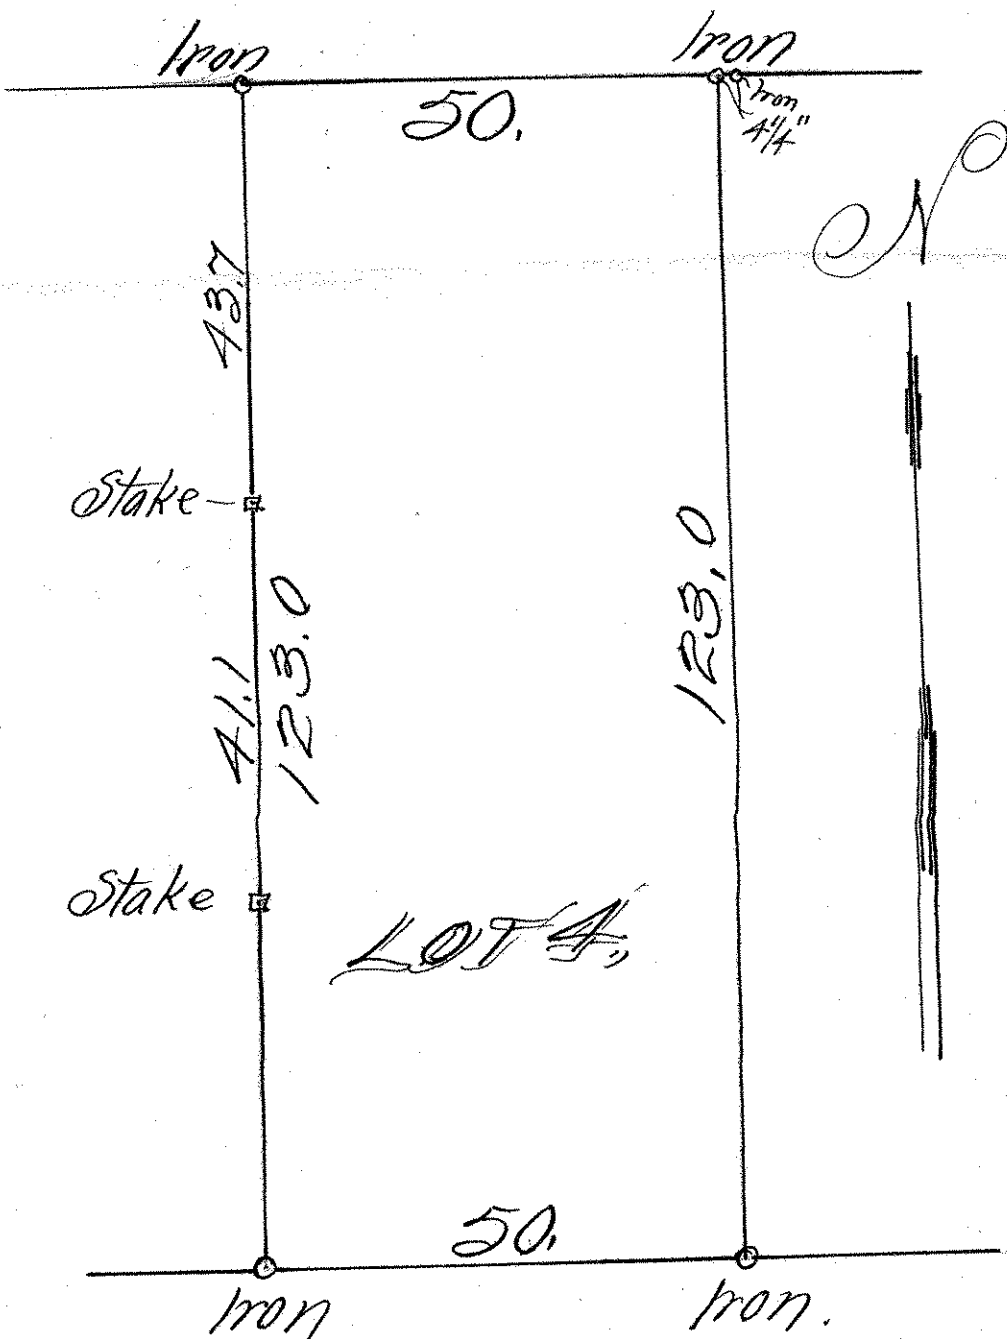

SCANNED ON

ALLEY 20.