


LOT 11 BLOCK 3  
UNDERWOOD'S 1<sup>ST</sup>  
ADDITION.

John B. Irvine, Surveyor.  
285 Mackubin St.  
St. Paul, Minn.  
April 9-1920  
Scale 20ft. per inch.

FAIRMOUNT AVE.

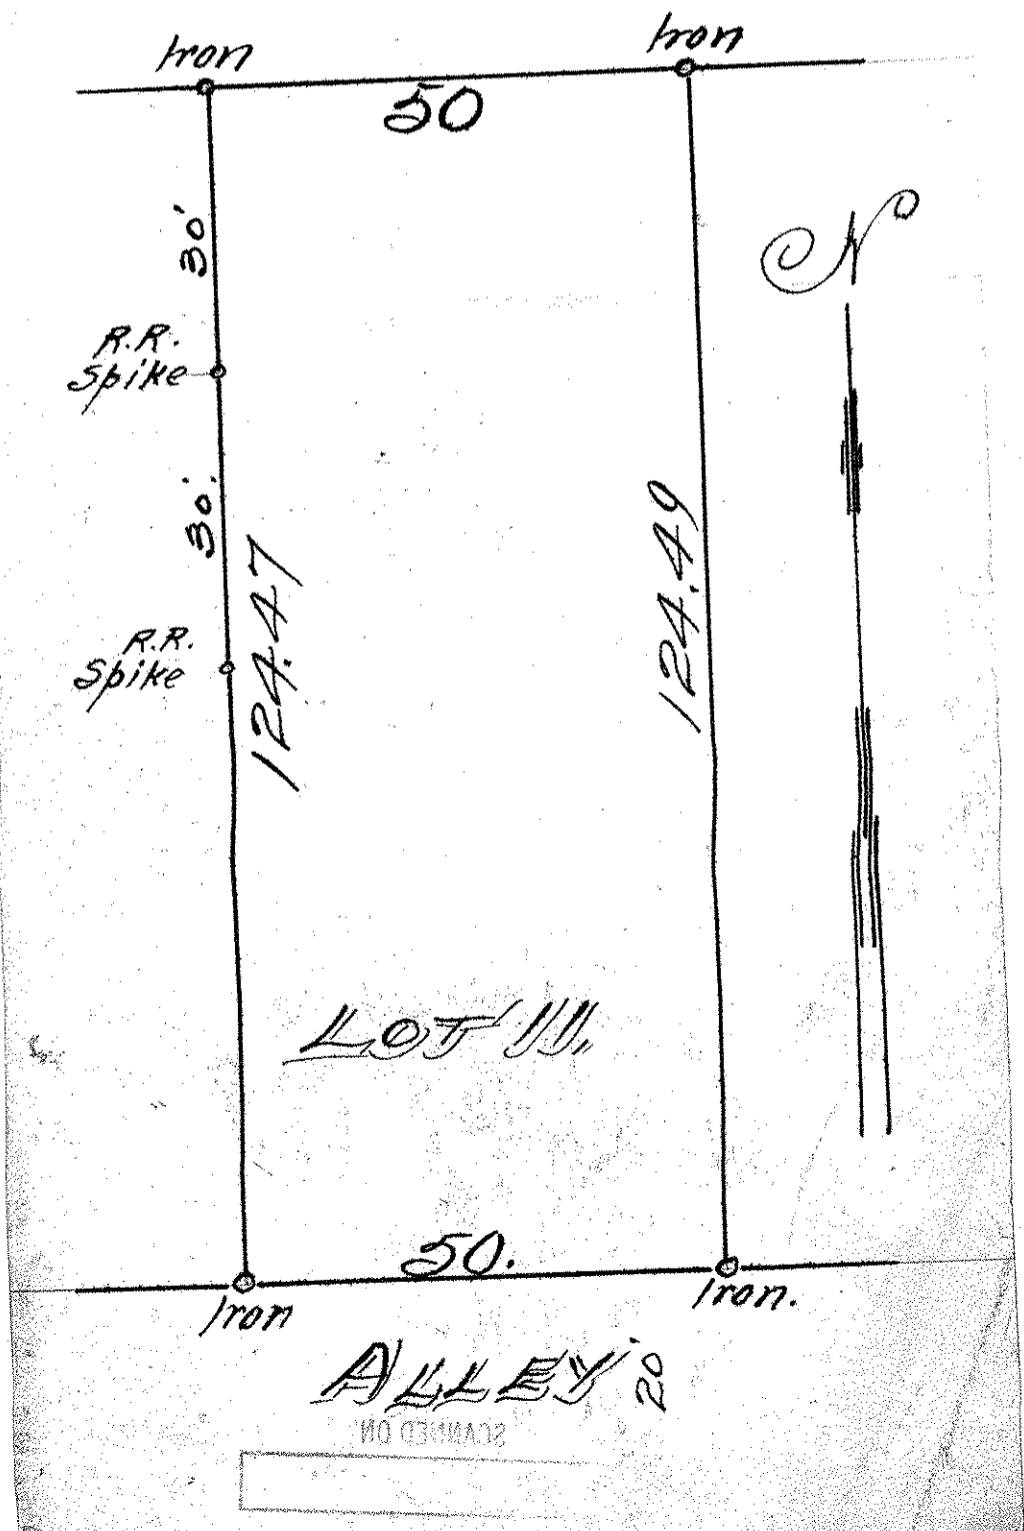

SCANNED ON