


LOTS 1 TO 8 BLOCK 1
 UNDERWOOD'S 1ST ADD.

JOHN B. IRVINE, SURVEYOR.
 408 GLOBE BLDG.
 ST. PAUL, MINN.
 OCT. 11-1910.
 SCALE 40 ft. per inch.

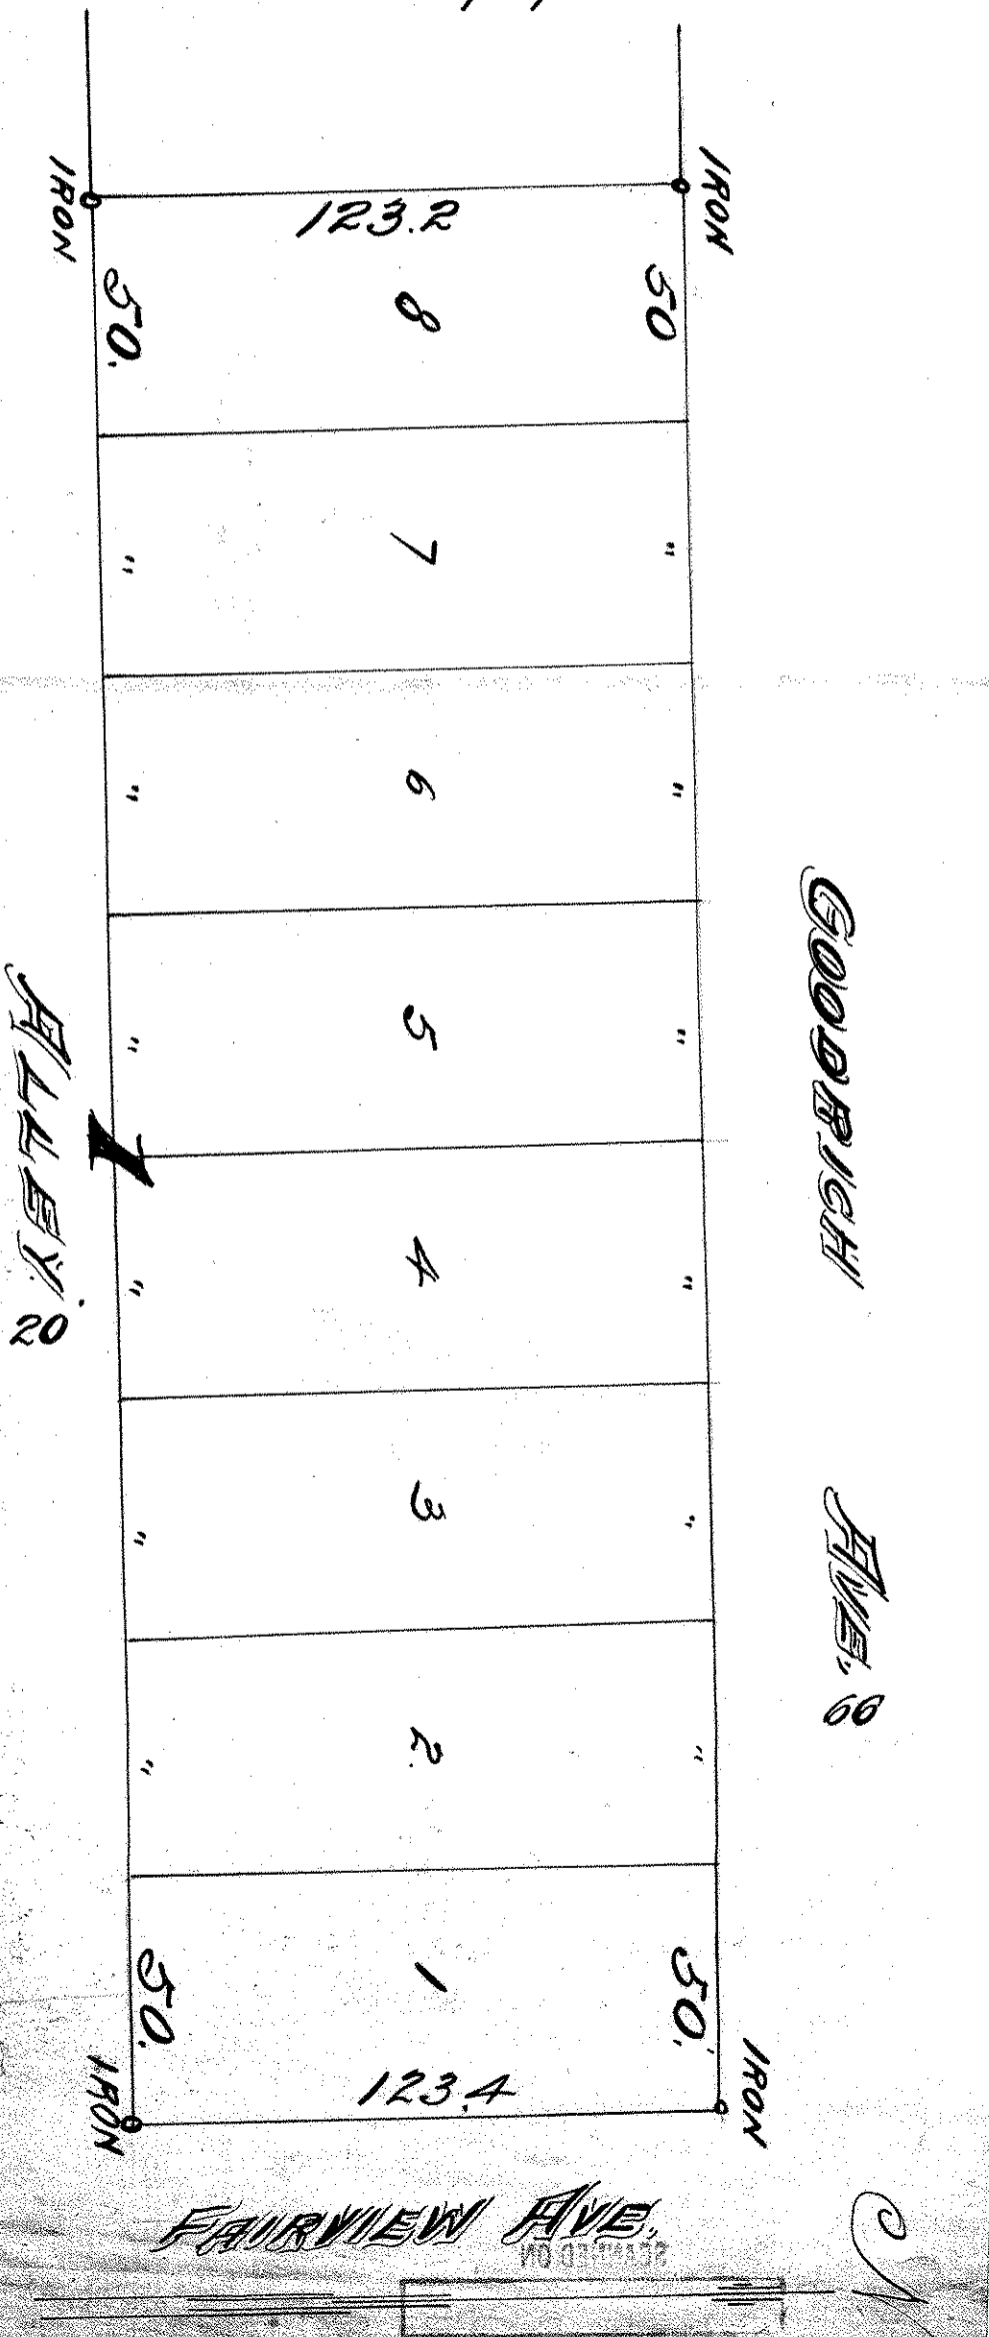

FAIRVIEW AVE.