

UNDERWOOD'S 3RD ADD.

SURVEY OF

LOT 3,

BLK. 4.

DEC., 2, 1916.


JOHN B. IRVINE

CIVIL ENGINEER & SURVEYOR.

SCALE 1"=20'

FAIRMOUNT

AVE.

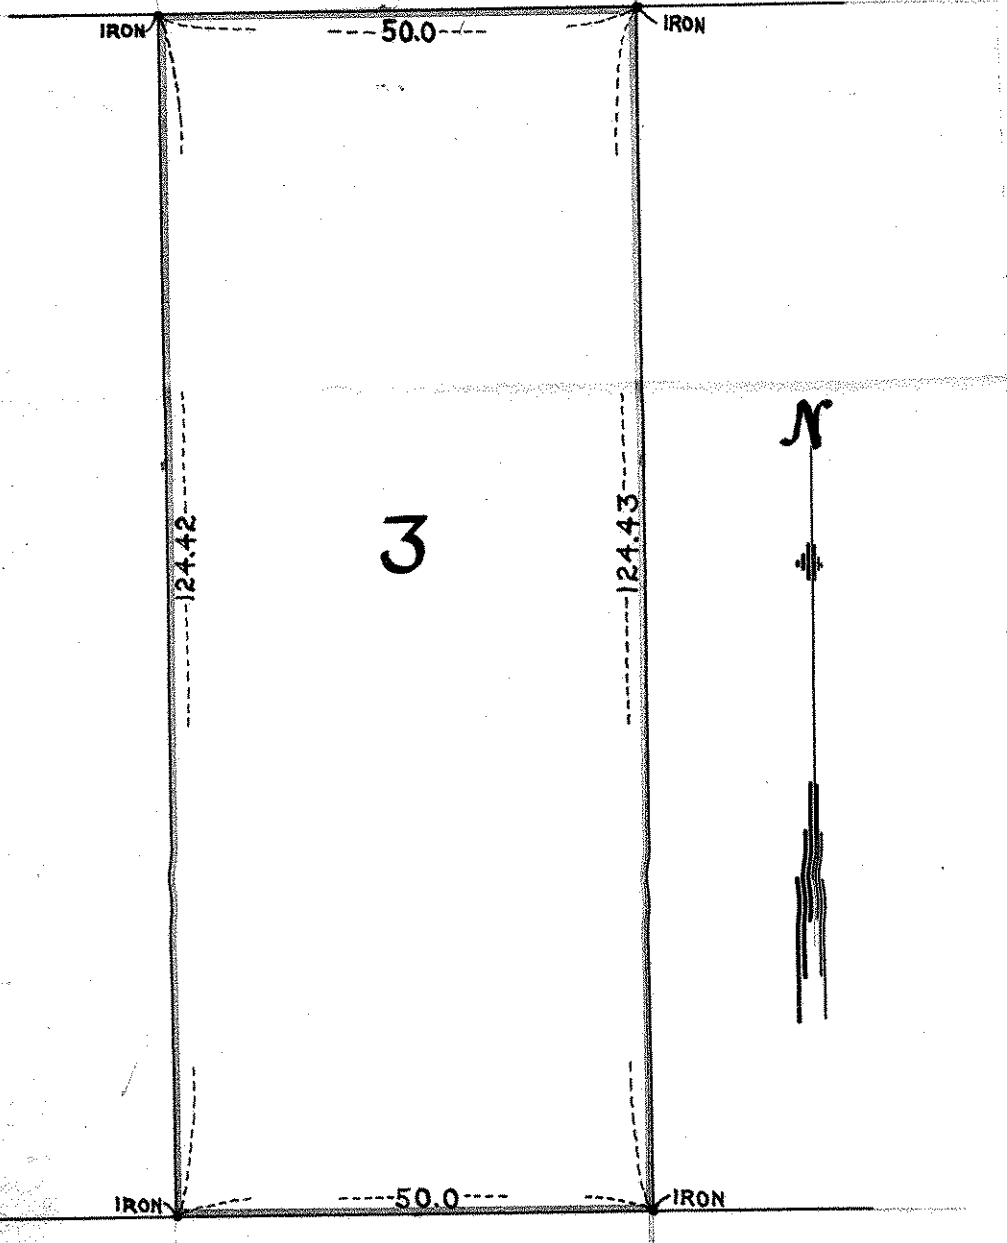

ALLEY

20