

LOT 10 BLOCK 5

UNDERWOOD'S 3<sup>RD</sup> ADD.

JOHN B. IRVINE, SURVEYOR


408 GLOBE BLDG.

ST. PAUL, MINN.

JULY 21-1916.

Scale 20ft. per. inch.

PRINCETON AVE.

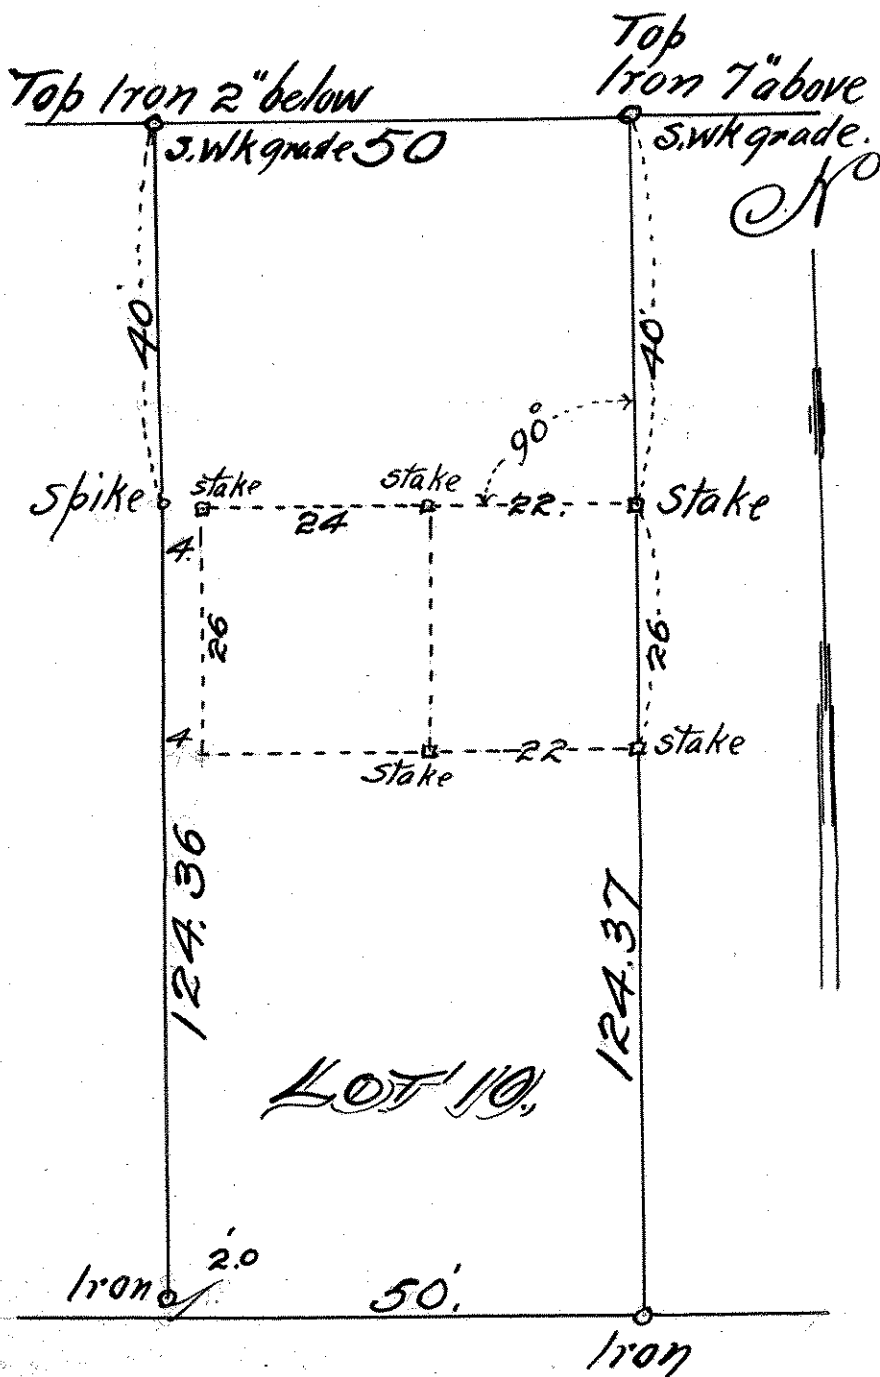

ALLEY 20

SCANNED ON