

LOTS 1, 2 & 3 BLOCK 1.
 UNDERWOOD'S 3RD ADD.

JOHN B. IRVINE, SURVEYOR.

408 GLOBE BLD'G.

ST. PAUL, MINN.


AUG. 15-1913.

scale 20 ft. per inch.

N

GOODRICH

AVE.
Iron

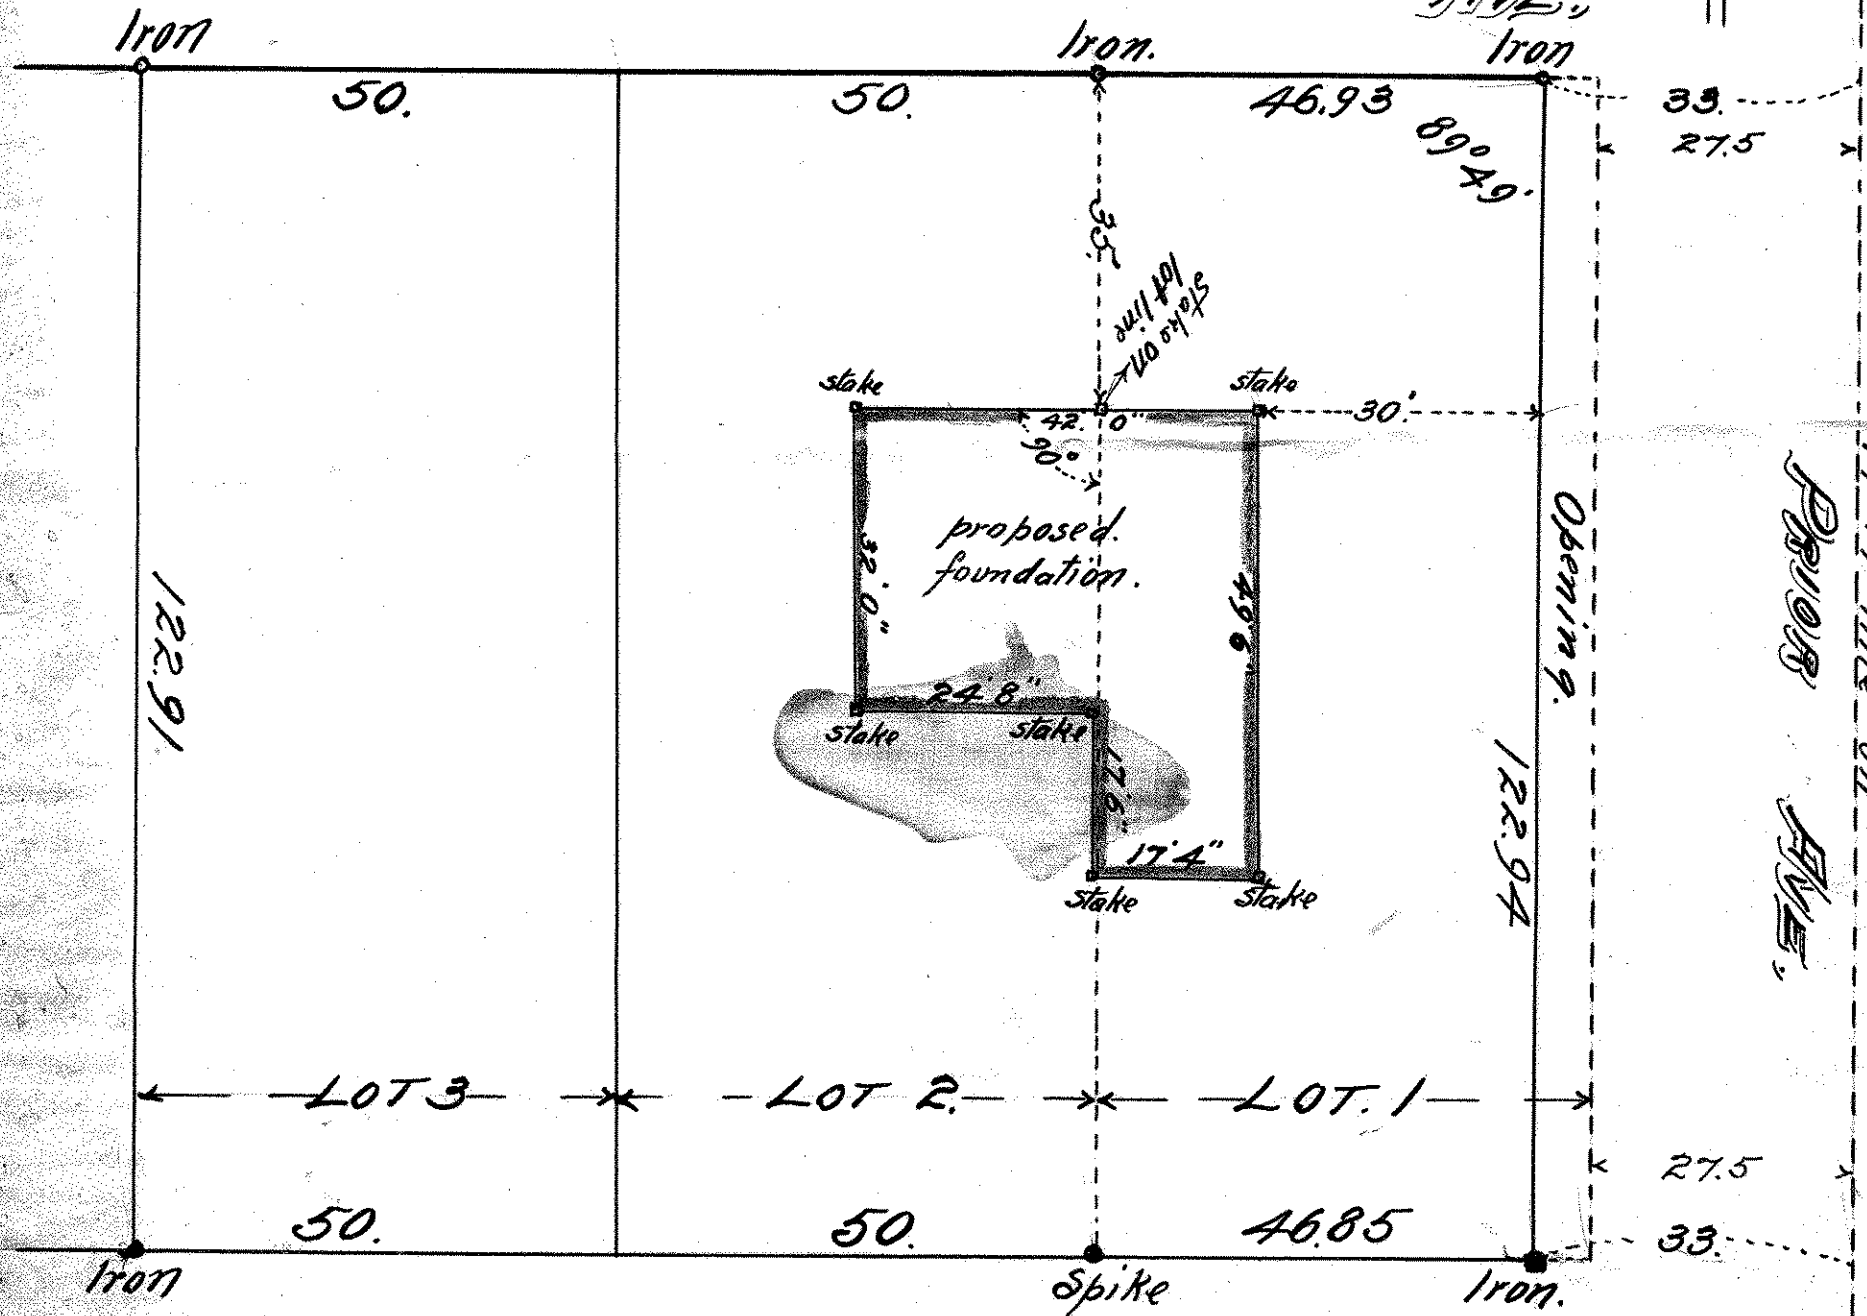

1/4 1/4 line on AVE.
 PRIOR LINE ON AVE.

ALLEY ST.

NO. 01111111