
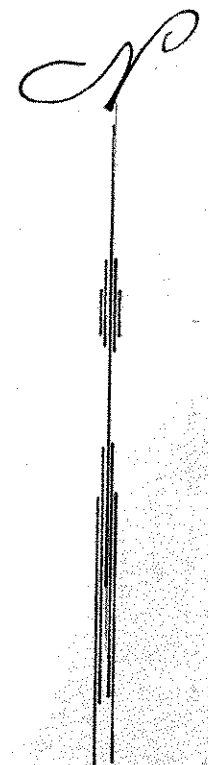


LOT 100 UNION PARK.

20' = 1"
Oct. 2nd '03.
J. W. Shugard

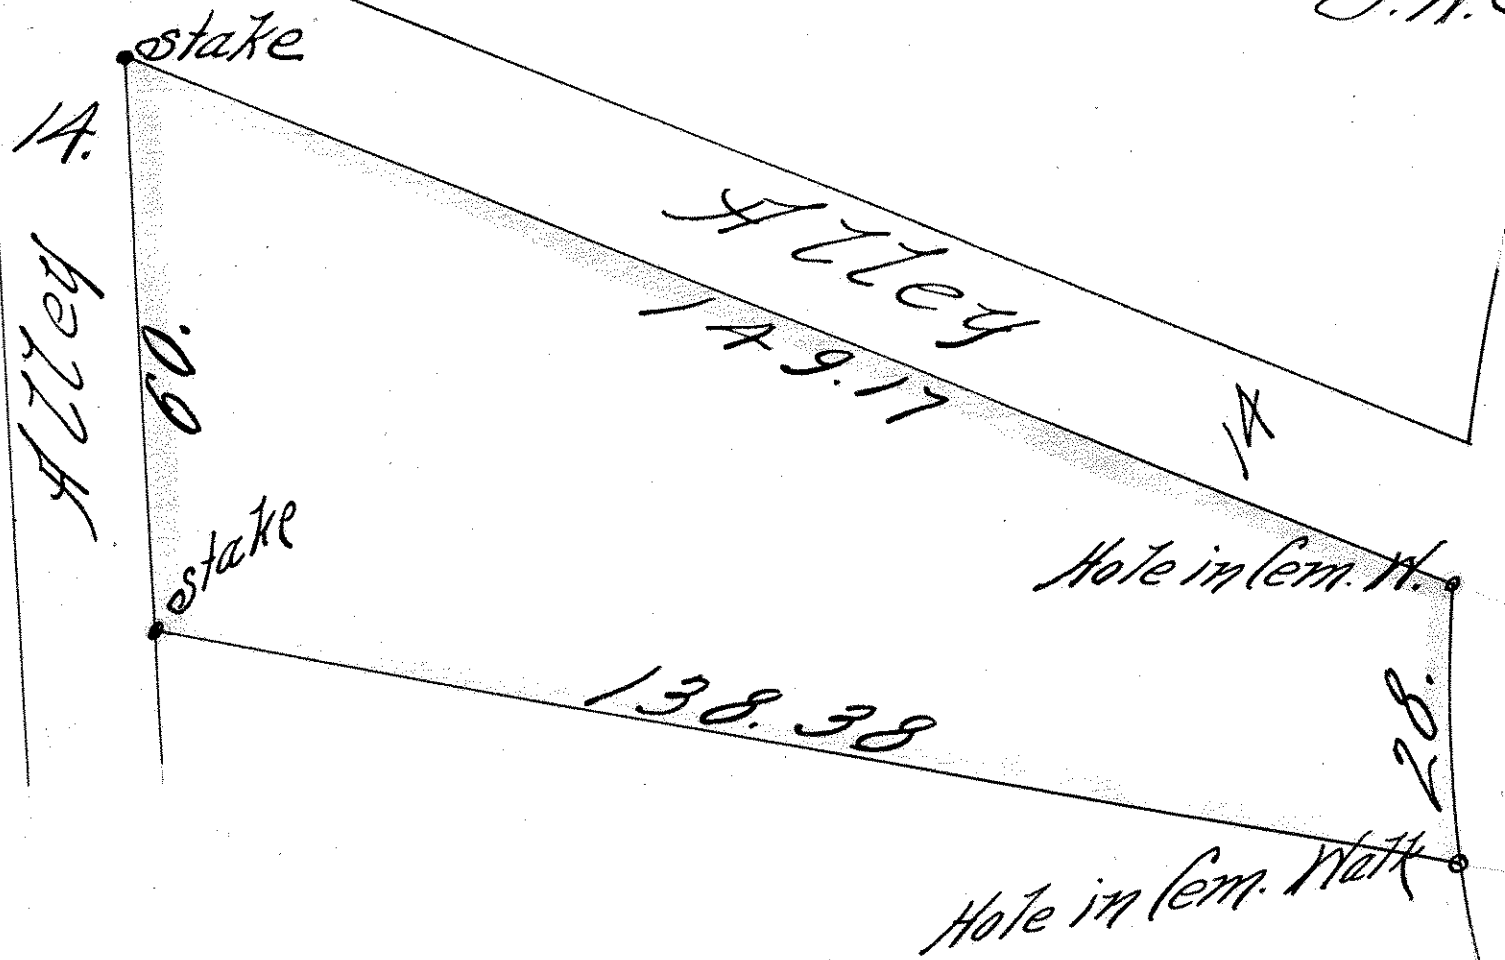

DENNEY AVE.