LOT 92 UNION PARK

Surv. June 17th '03 For H.M. Gosby
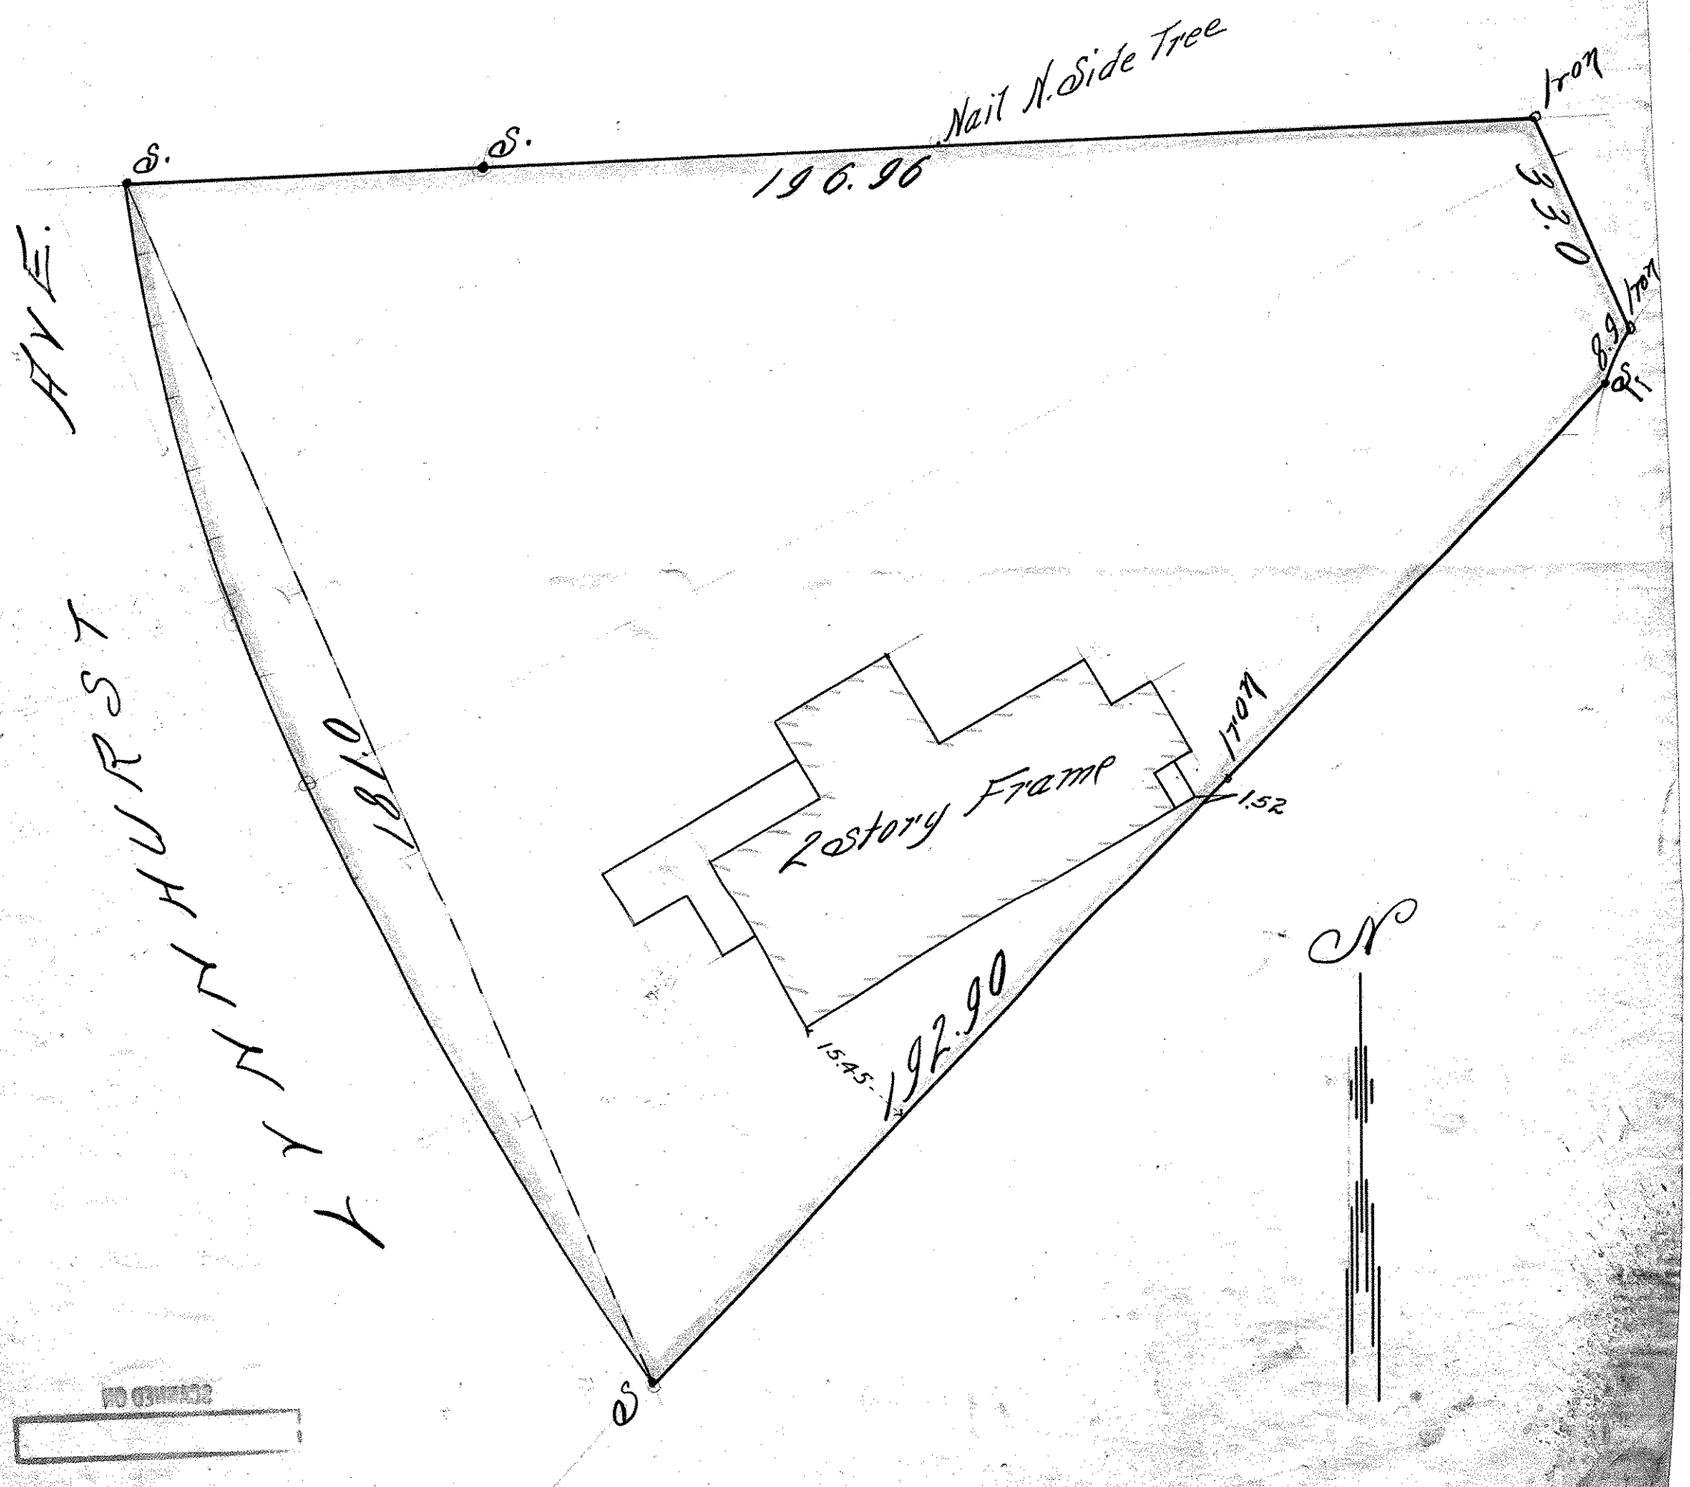
20' = 1"