


LOTS 29 & 30 UNION PARK
20' = 1"
SUR JULY 25th 1903 E. HOLLOWELL
May 19-1909

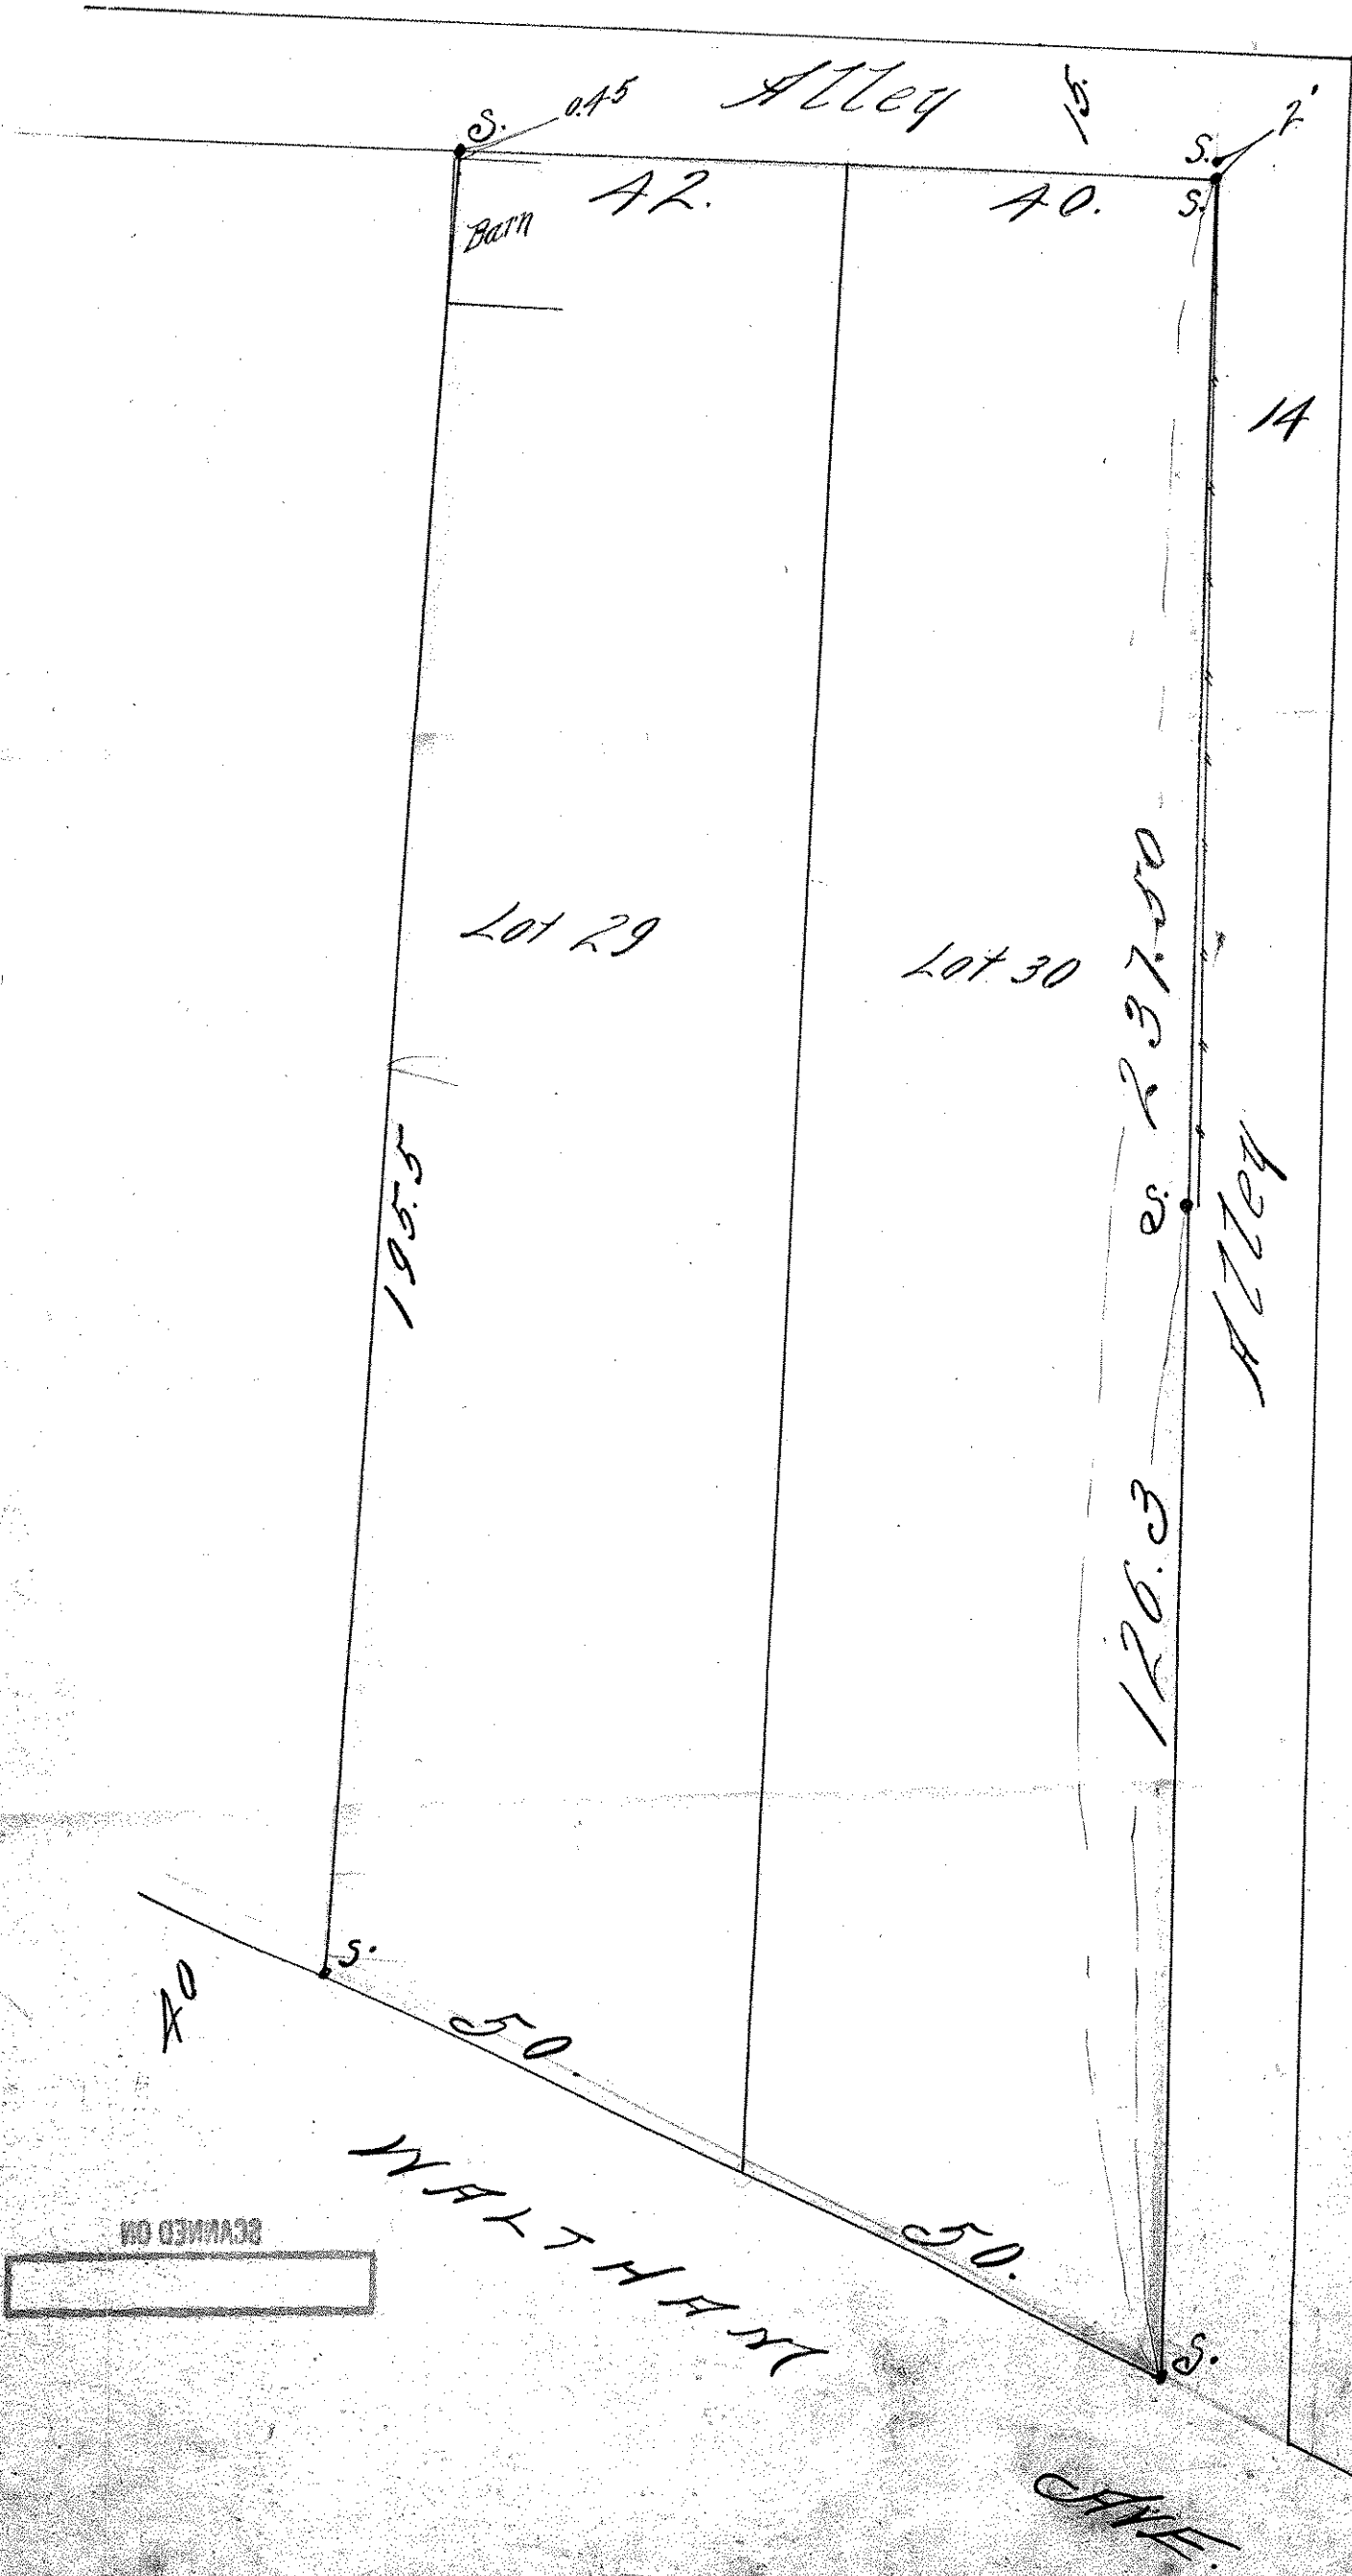

SCANNED ON