


LOT 5 BLOCK 2 UNIVERSITY AVE. ADD.

JOHN B. IRVINE SURVEYOR
ROOM 416 GLOBE BLD'G.
ST PAUL MINN.
MAY 22-06.

SCALE 1 IN. = 20 FT.

ALLEY

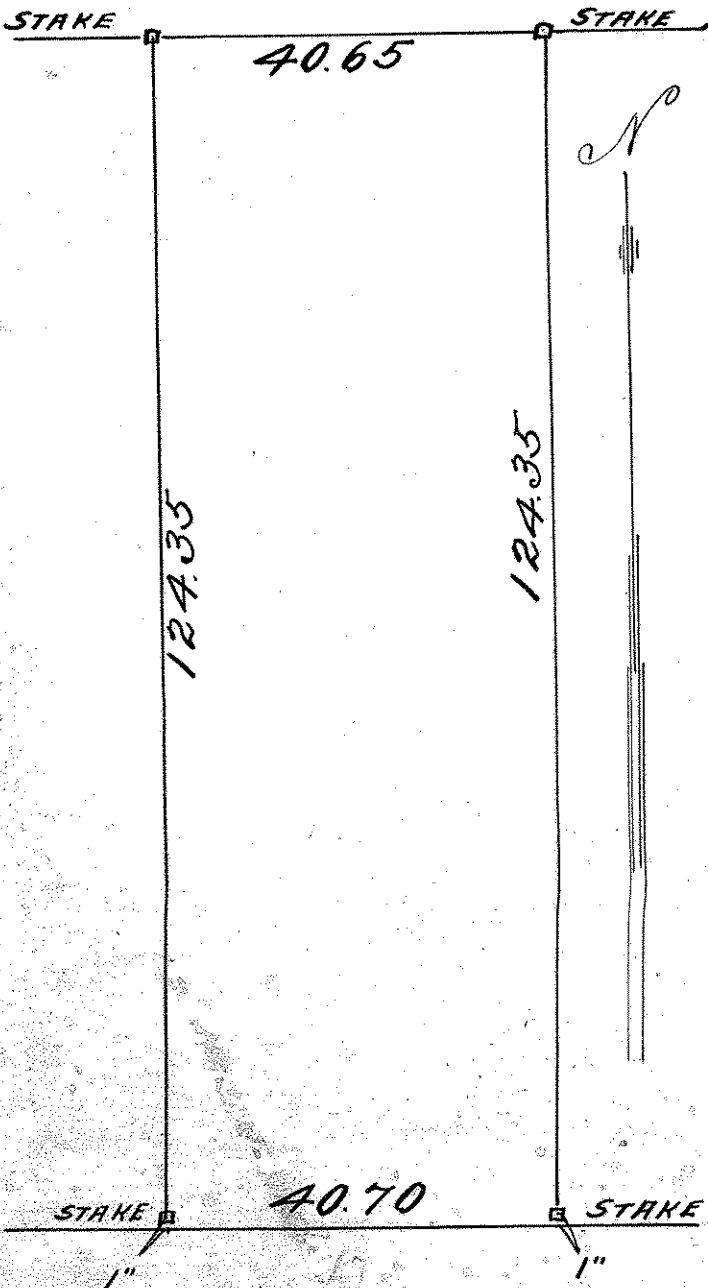

CHARLES ST.

RECORDED ON
[]