

LOT 6, BLK. 2.

UNIVERSITY AVE. ADD.

JOHN B. IRVINE, SURVEYOR.


416 GLOBE BLDG

ST. PAUL MINN.

NOV. 1 - 07.

NOV 1907

scale 20ft. per inch.

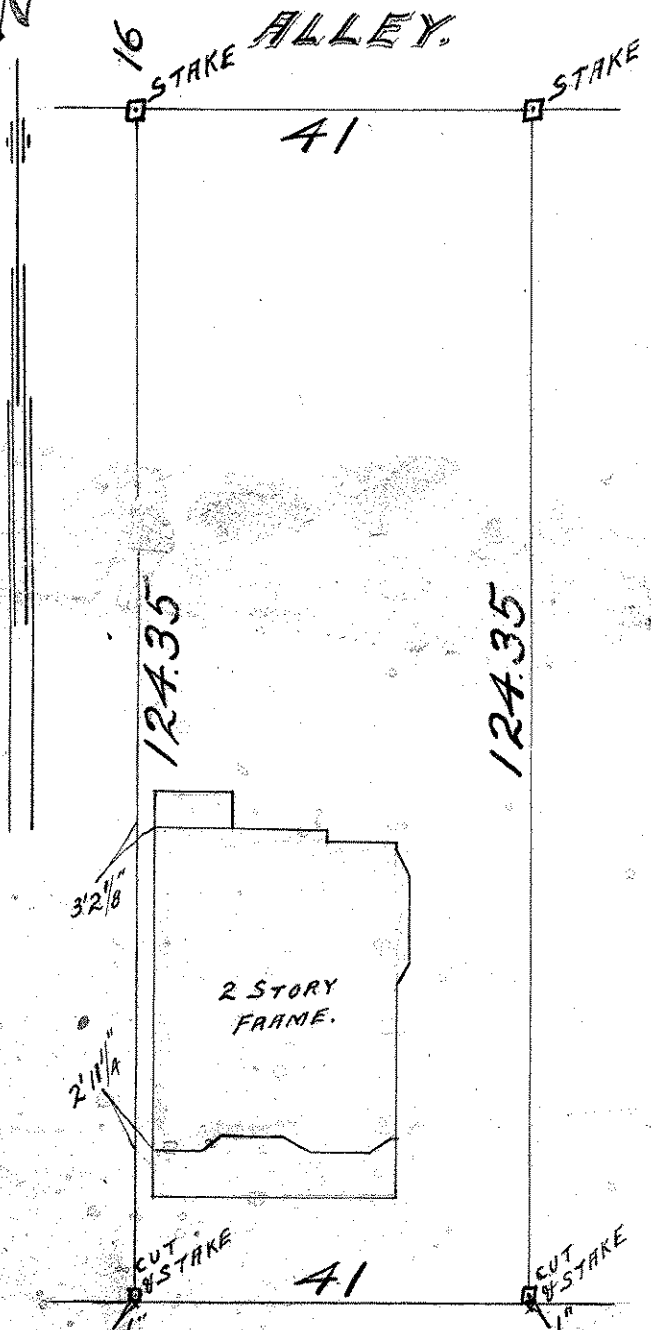

60 CHARLES ST.