LOT 7 BLOCK 3
UNIVERSITY AVE. ADD.
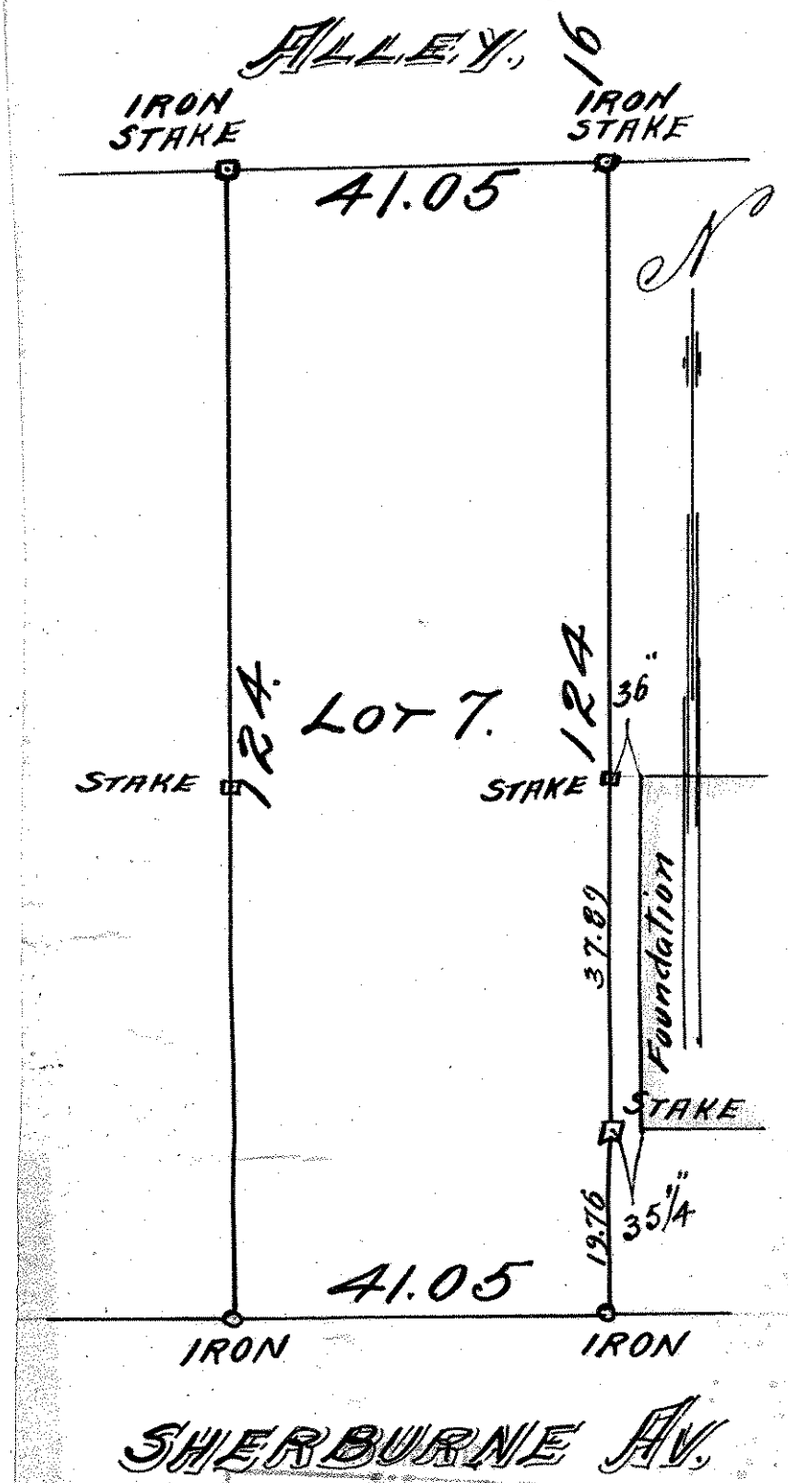
JOHN B. IRVINE, SURVEYOR.
OCT. 27-1908
SCALE 20 ft per inch.
MAY 19-1909.