

LOT 16 BLOCK 1.

UNIVERSITY SUB.


JOHN B. IRVINE SURVEYOR.

408 GLOBE BLD'G.

ST. PAUL MINN.

July 29 1913

ALLEY

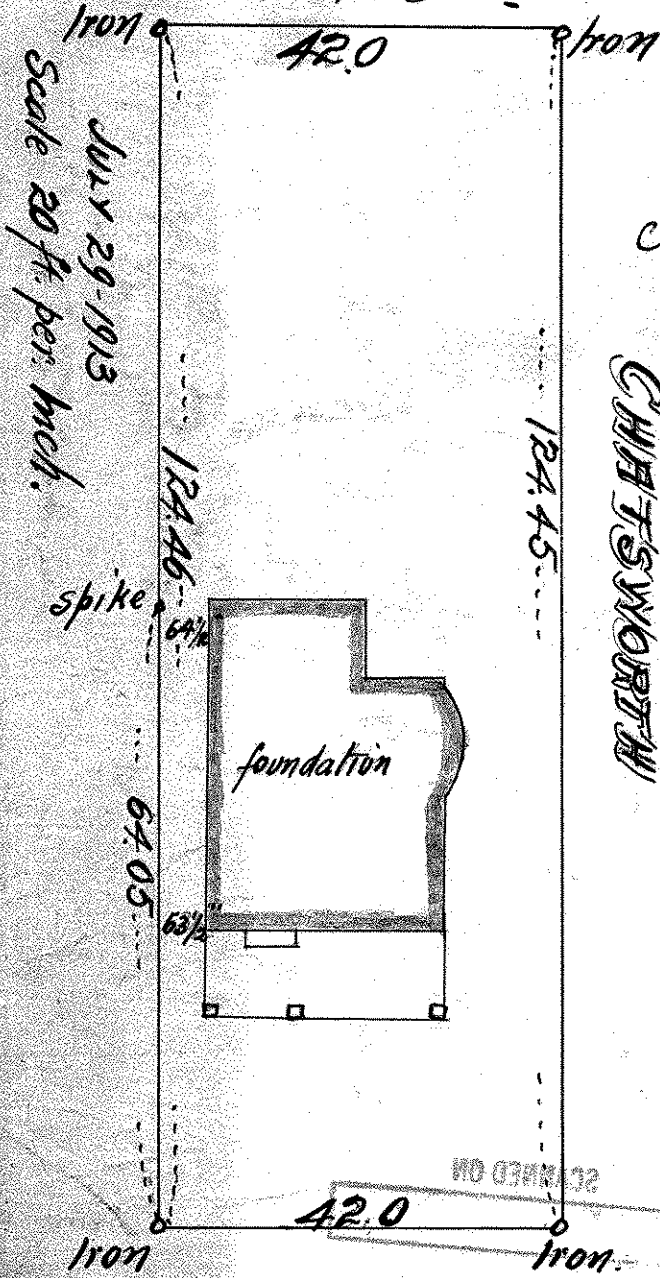

Scale 20 ft. per inch.

July 29-1913

CHATS WORTH

SHERBURNE AVE.