

14
LOT 3, BLOCK 4

UNIVERSITY SUBDN.,

OF

LOTS 1-2-3-8 HYDE PARK

JOHN B. IRVINE SURVEYOR.


ROOM 406 GLOBE BLDG.

SCALE 1 IN. = 20 FT.

ST PAUL MINN.

Oct 2 - 1905

AURORA AVE.

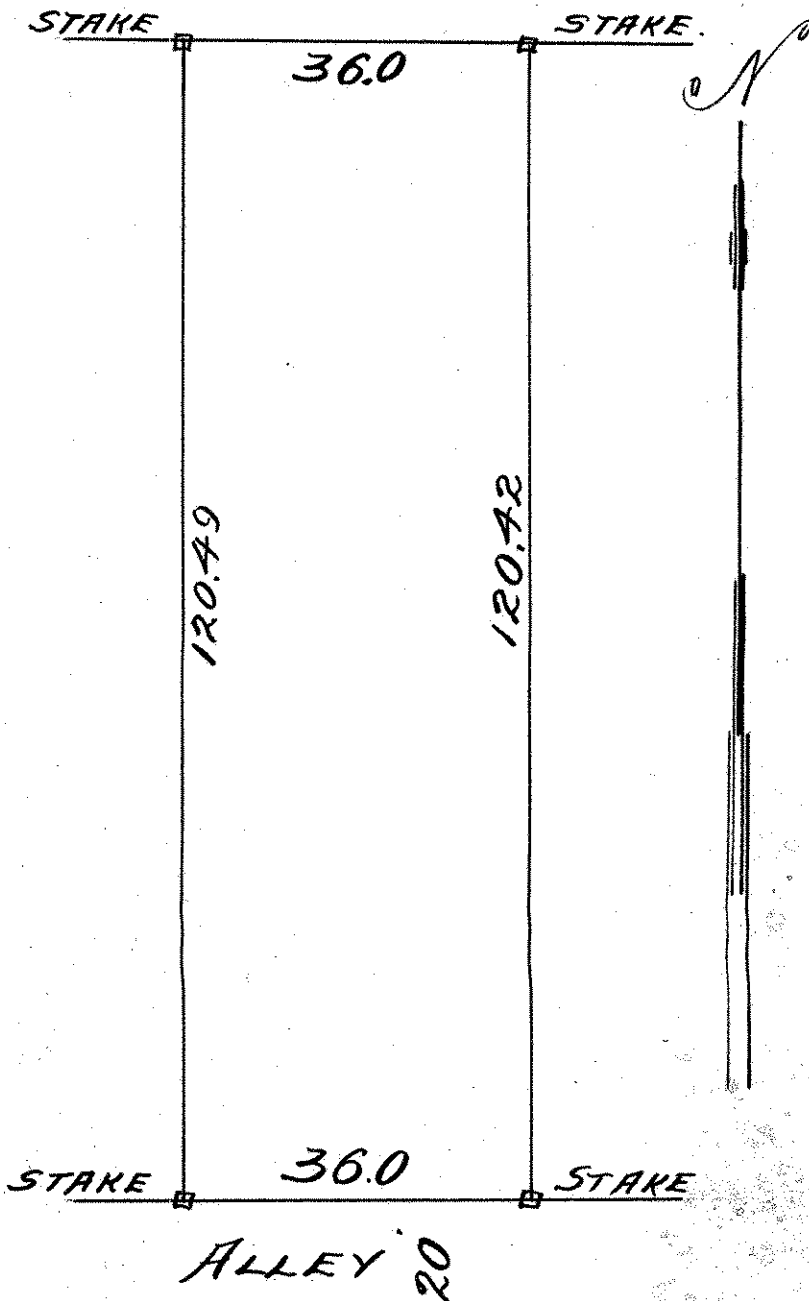

SCANNED ON