


LOT 9 BLOCK 1.  
UNIVERSITY VIEW  
ADDITION.

JOHN B. IRVINE SURVEYOR.  
416 GLOBE BLDG.  
ST PAUL MINN.

SCALE 1 IN. = 20 FT. SEPT 21-06.

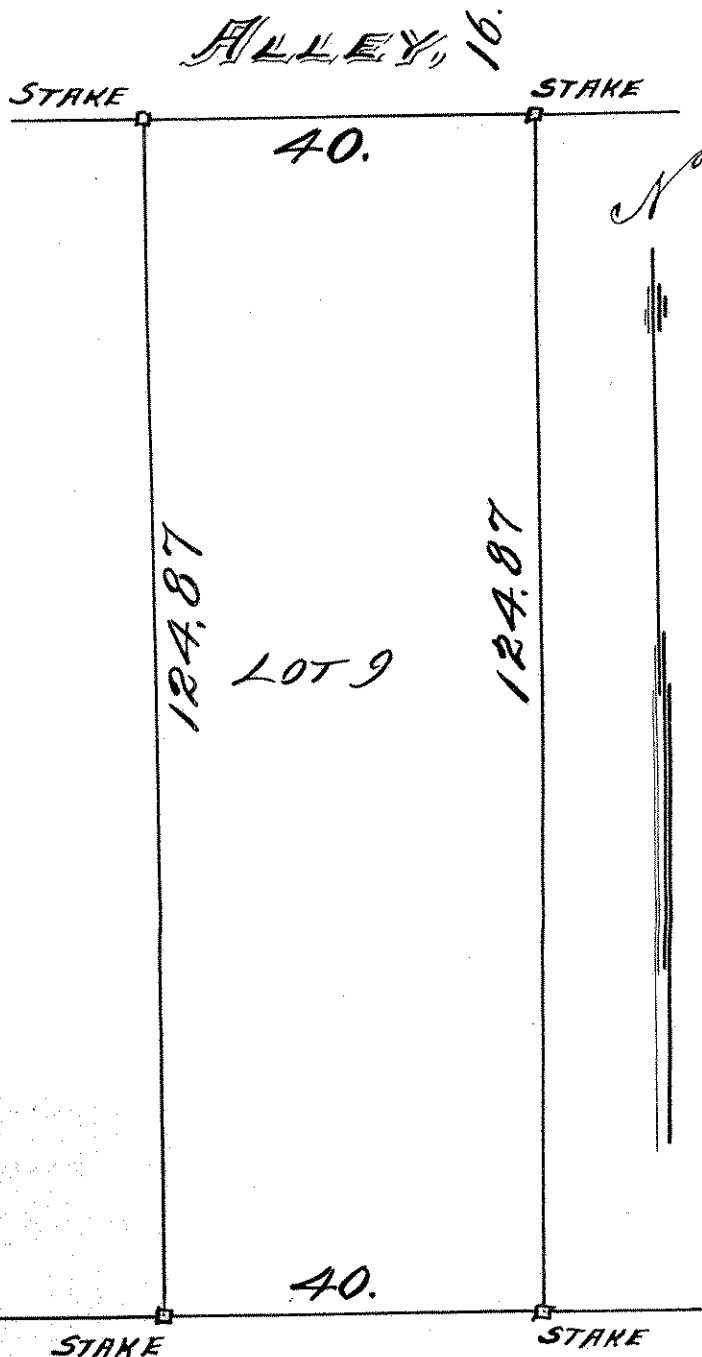

VAN BUREN ST. 60.

