


P. R. DANISTER
CIVIL ENGR.
25 7th Ave. - 100 St. Paul, Minn.
PHONE - N. ST. 7, 35

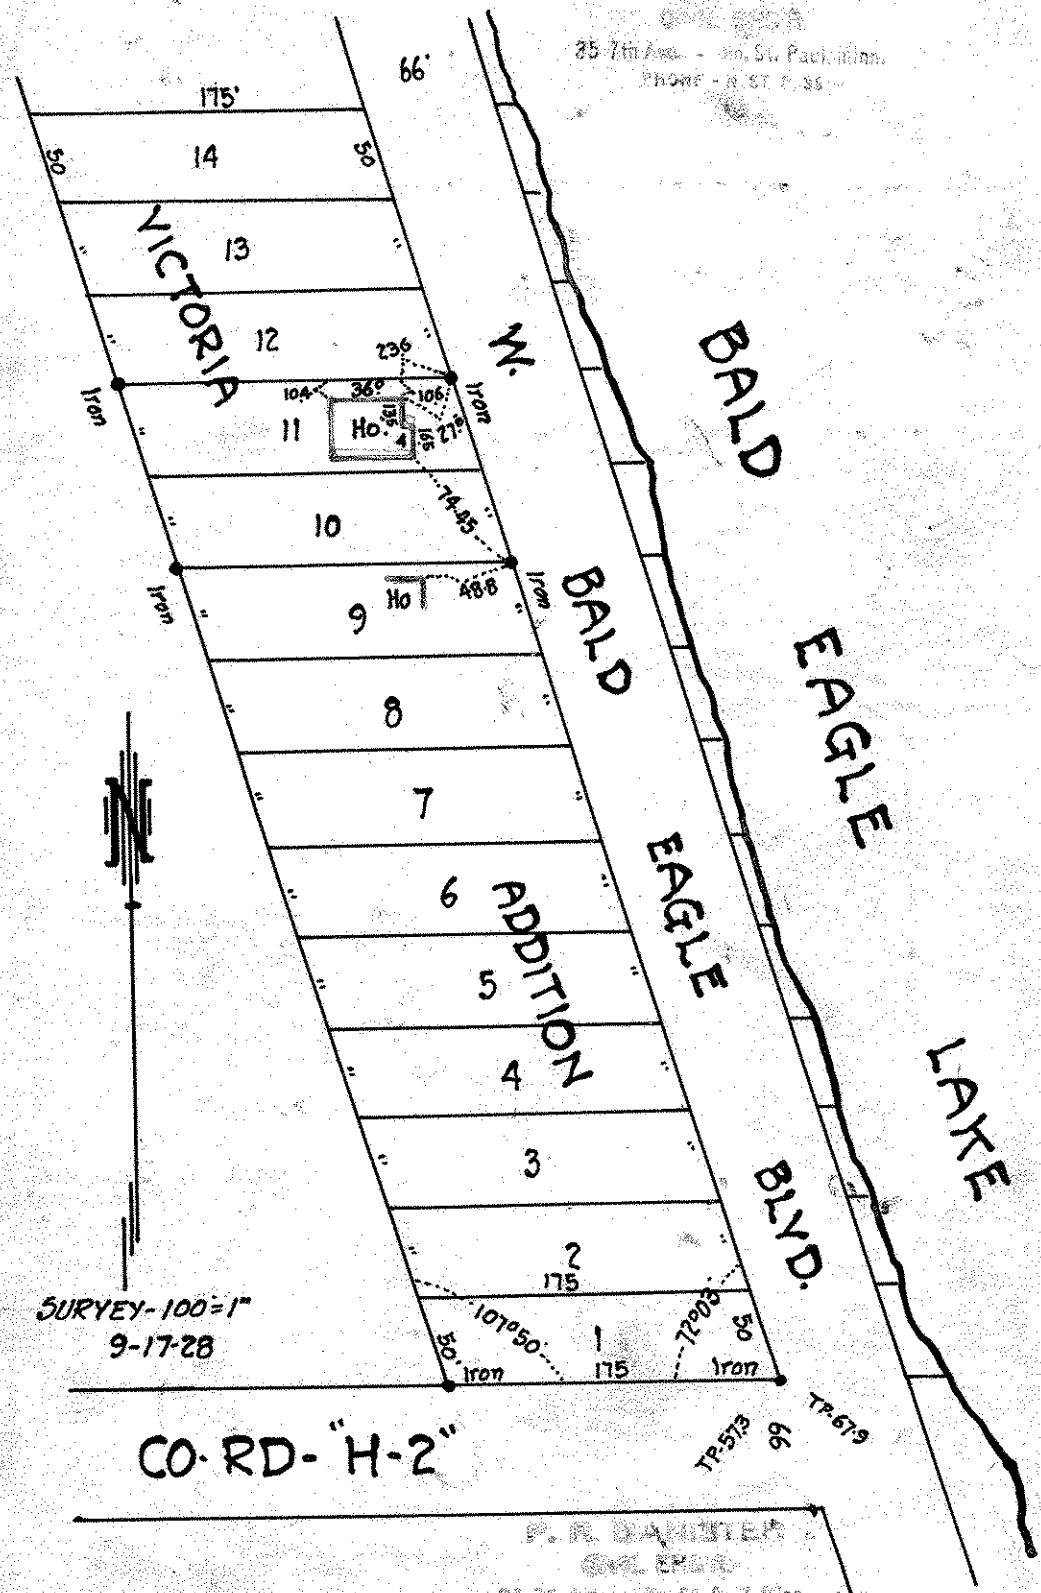

SURVEY-100=1"
9-17-28

CO. RD. "H-2"

P. R. DANISTER
CIVIL ENGR.
25 7th Ave. - 100 St. Paul, Minn.
PHONE - N. ST. 7, 35

SEC-10-30-22