


LOT 18 BLOCK 3
WARE & HOSPE'S
ADDITION.

JOHN B. IRVINE, SURVEYOR.
408 GLOBE BLDG.
ST. PAUL MINN.
SCALE 20 ft. per inch.
JULY 9-1909

SIMON AVE.

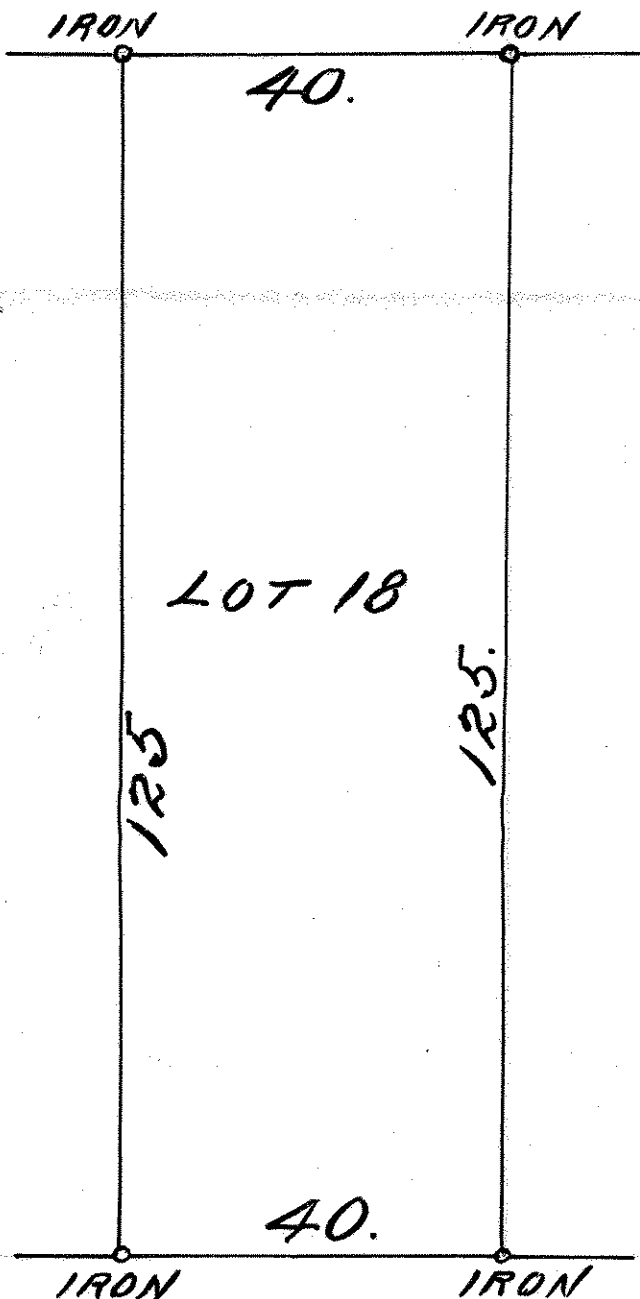

ALLEY, 20.