



LOTS 39, 40 & 41 BLOCK 2.

WARE & HOSPIES ADD.

John B. Irvine, Surveyor.

July 21-1921.

Scale. 20 ft. per inch.

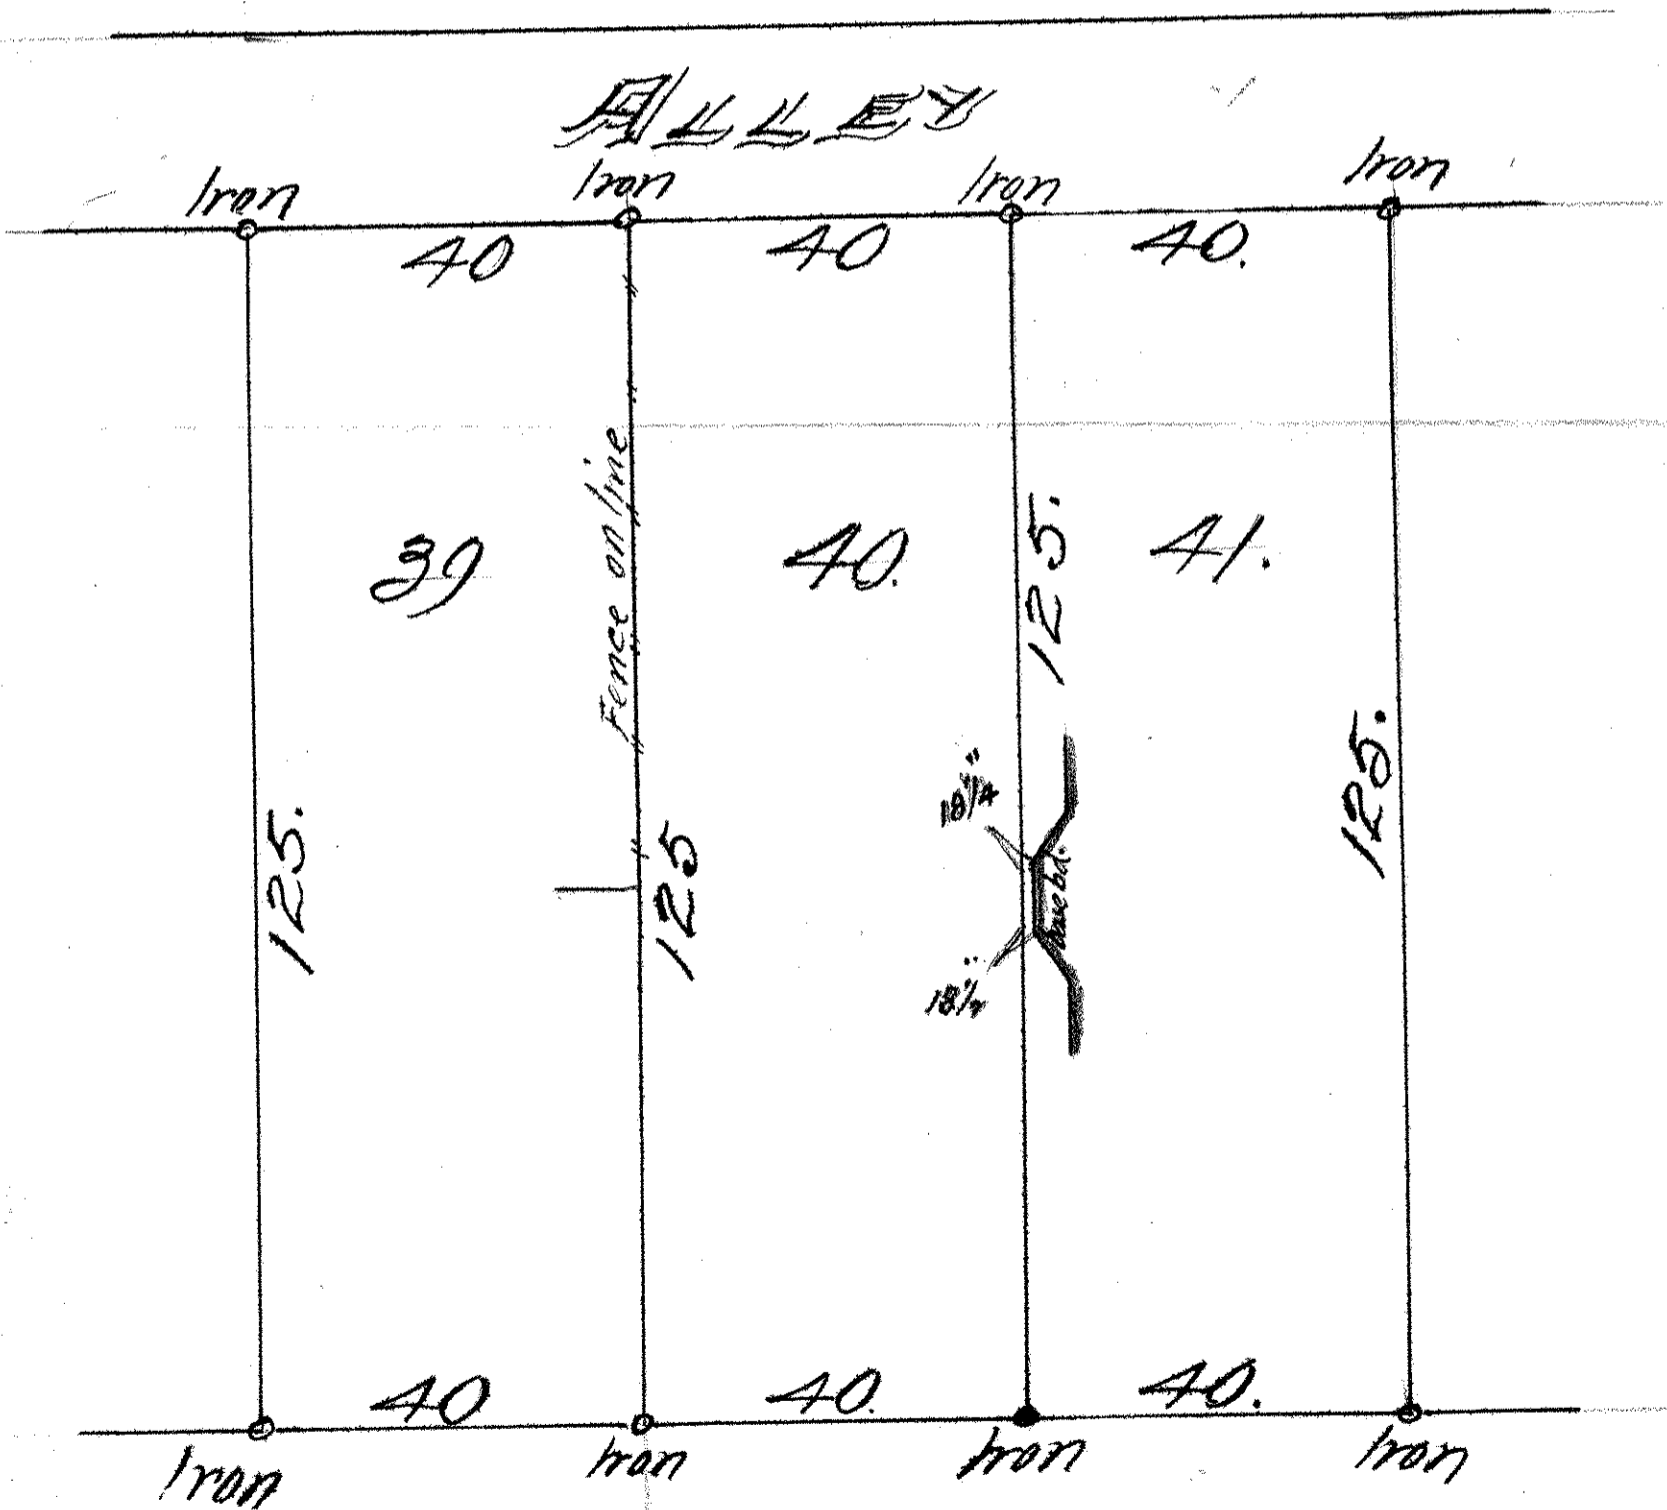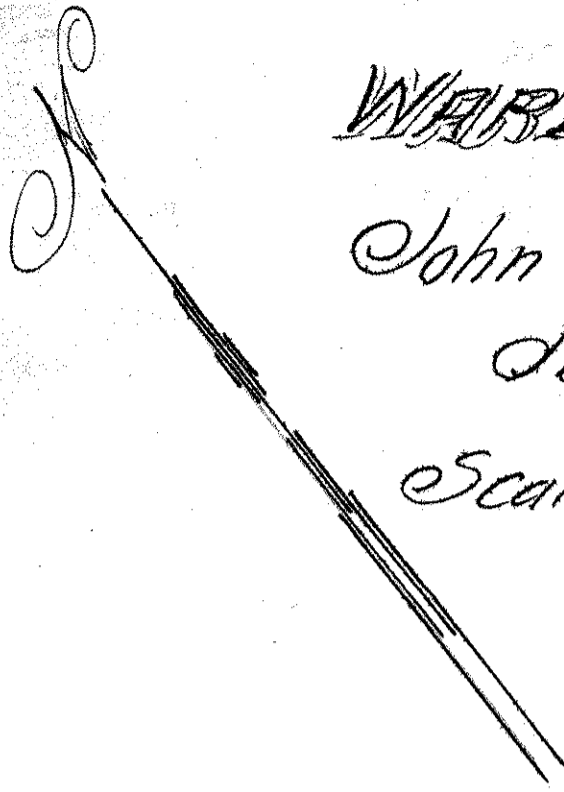

SIMON ALVIE,