

36 1/2 FT. EAST OF LOT 4 BLK 27

WARREN & RICE'S ADD.

JOHN B. IRVINE SURVEYOR.

ROOM 508 GLOBE BLDG


ST PAUL MINN.

APRIL 4-05.

SCALE 10'-1"

FARRINGTON AVE

E. LINE.

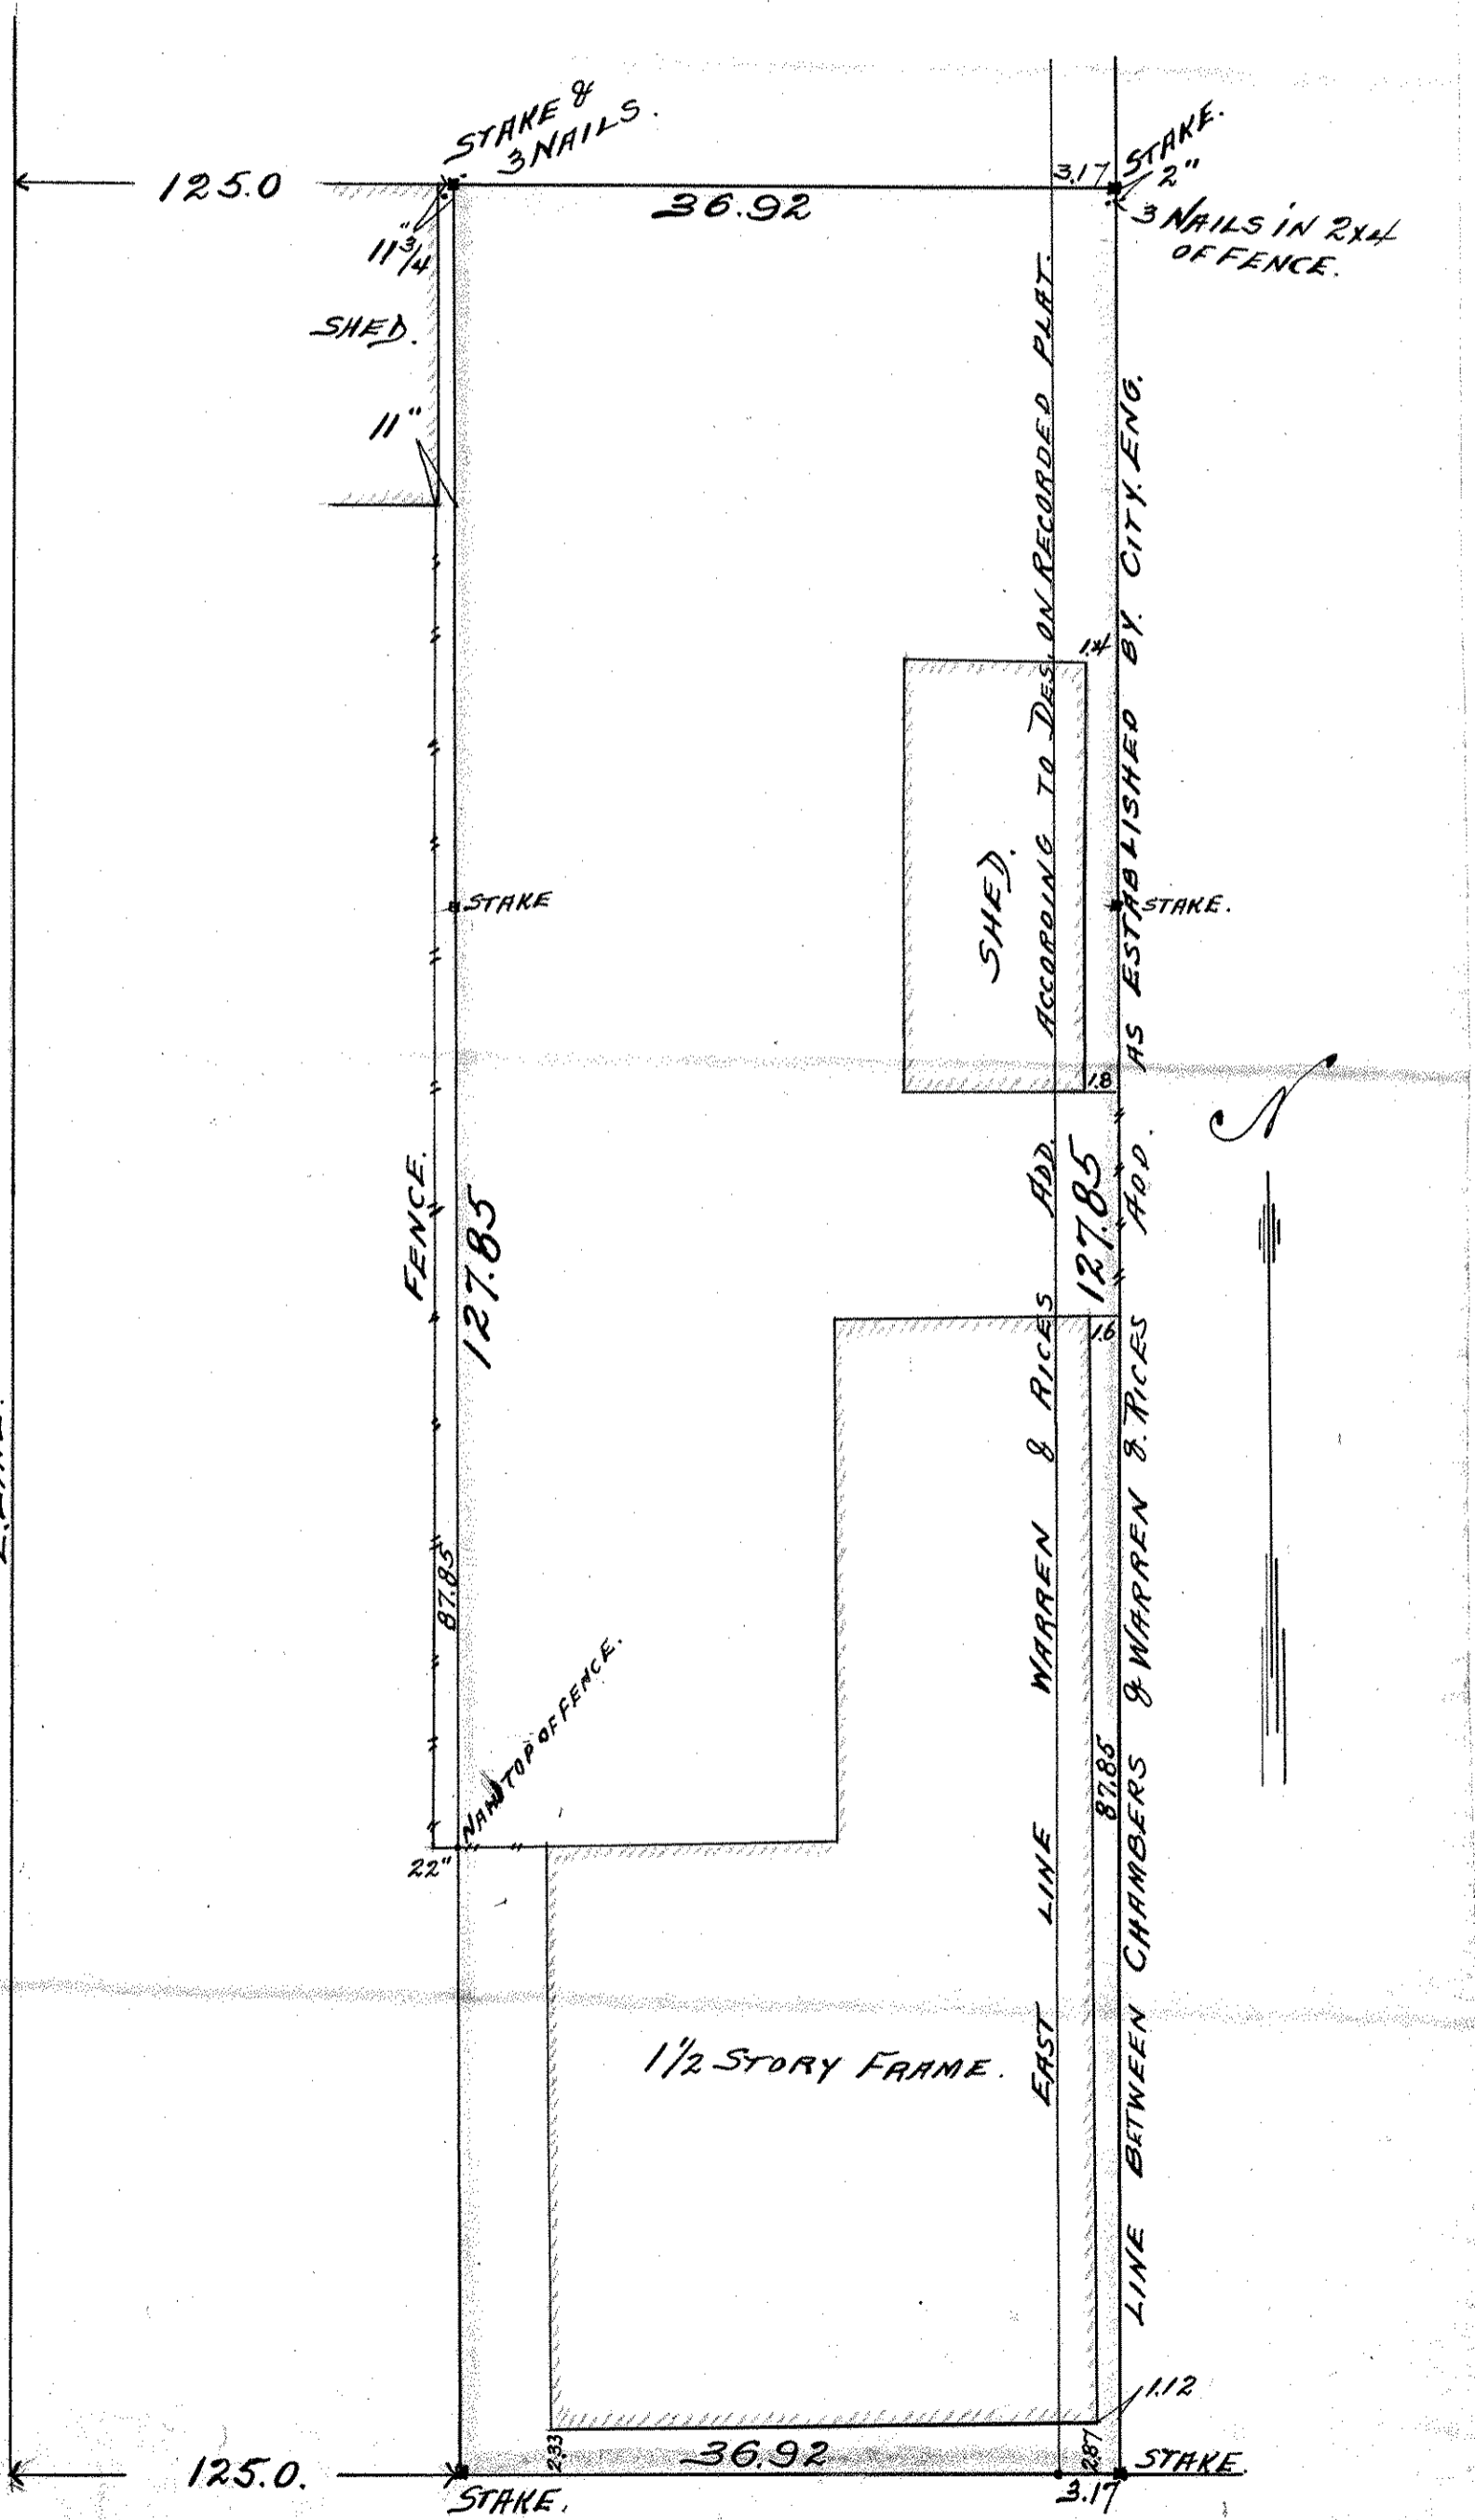

UNIVERSITY AVE.

6775  
13510