NORTH 35 ft. SOUTH 60 ft.
LOT 7 BLOCK 26
WARREN & RICE'S ADD.

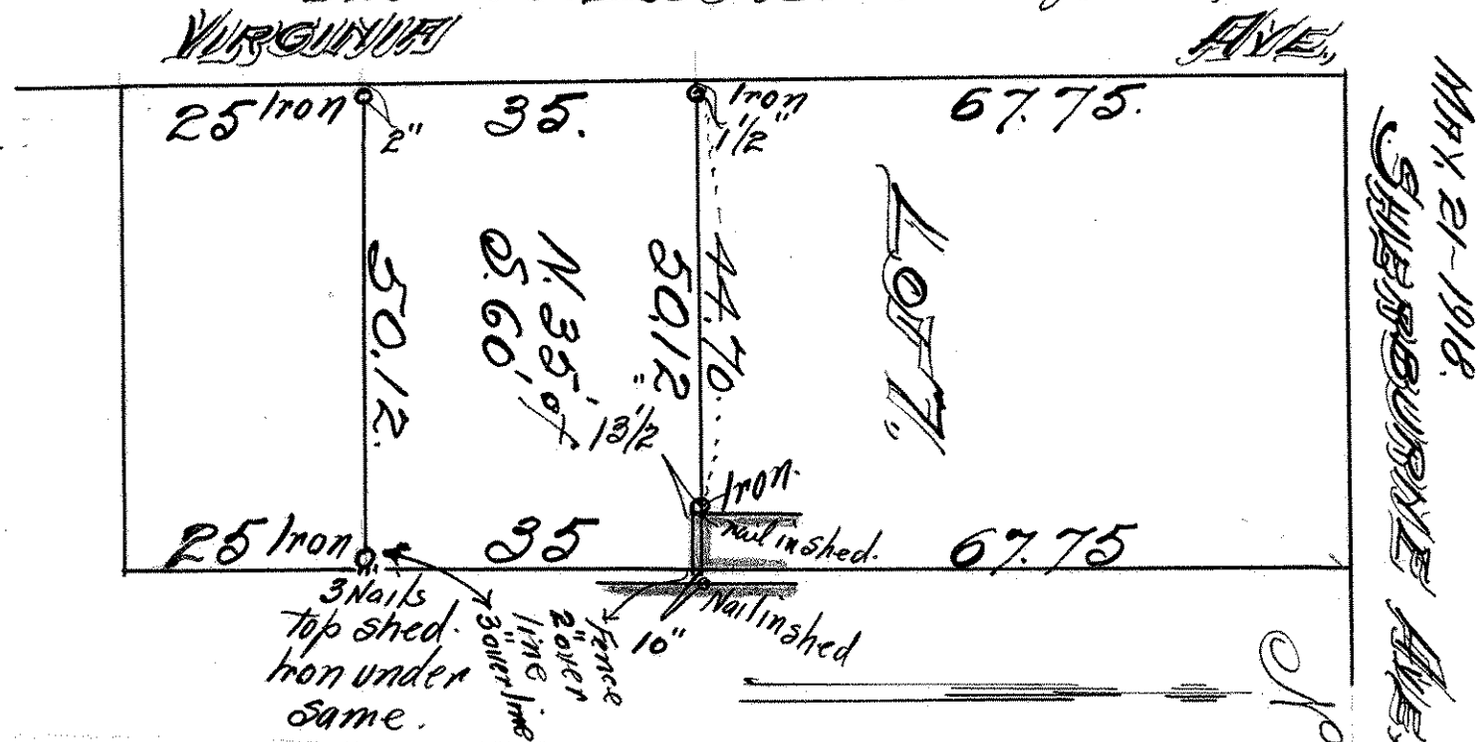

JOHN B. IRVINE, SURVEYOR.
ST. PAUL, MINN.
MAY 21-1918.