


LOT 5 BLOCK 9
WARREN & RICE'S
ADD.

20' = 1" May 21'04
Jno. Wardenberg

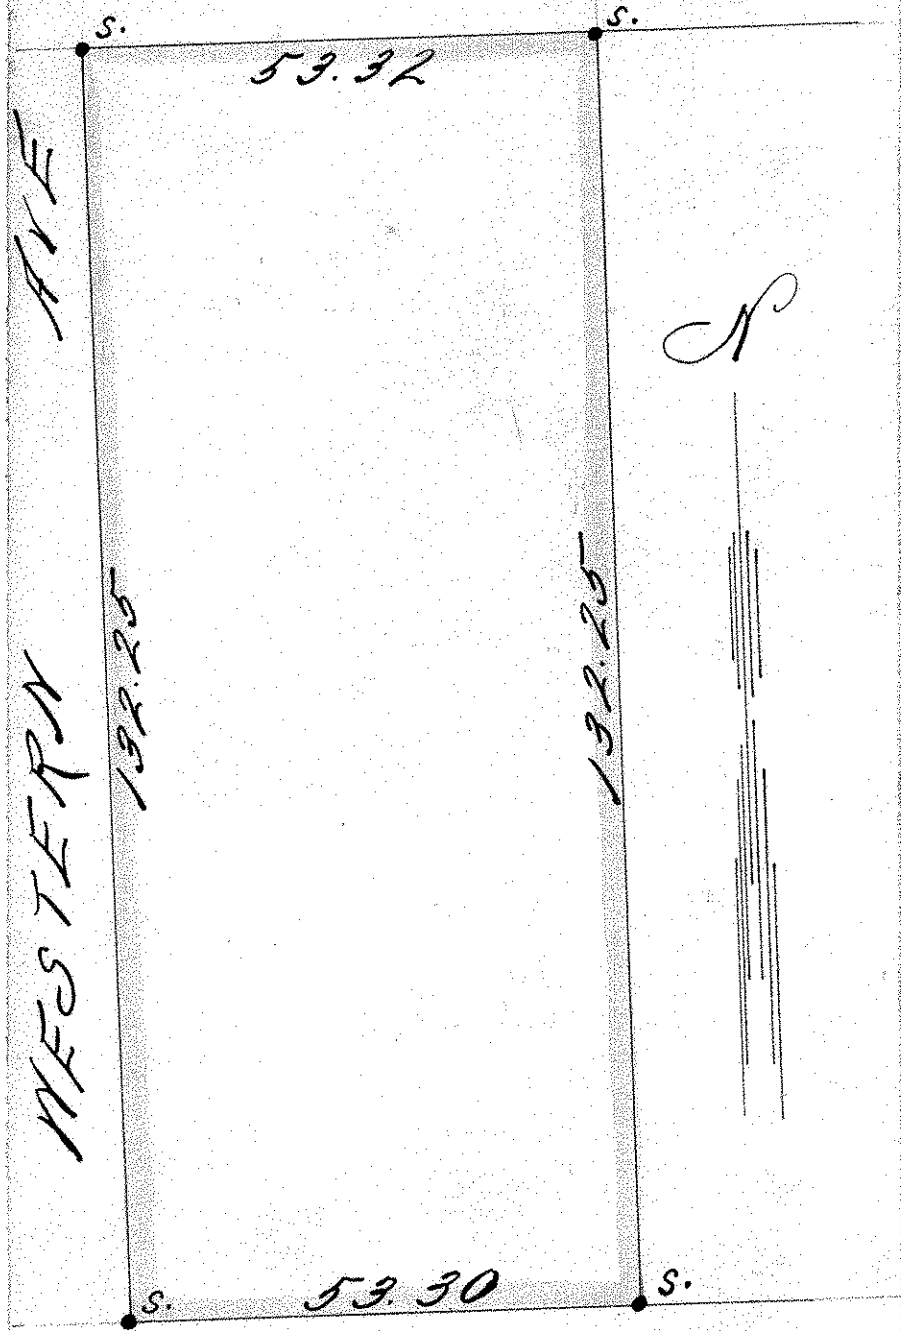


S. S.

CHARLES ST.