


LOTS 1, 2, 3, 4 & 5 BLK. 11 WARREN & WINSLOW'S ADD.

(COLLINS (opening) ST.

20' = 1" ^{PL} '04
Sep. 19 " '04

De Lauris.

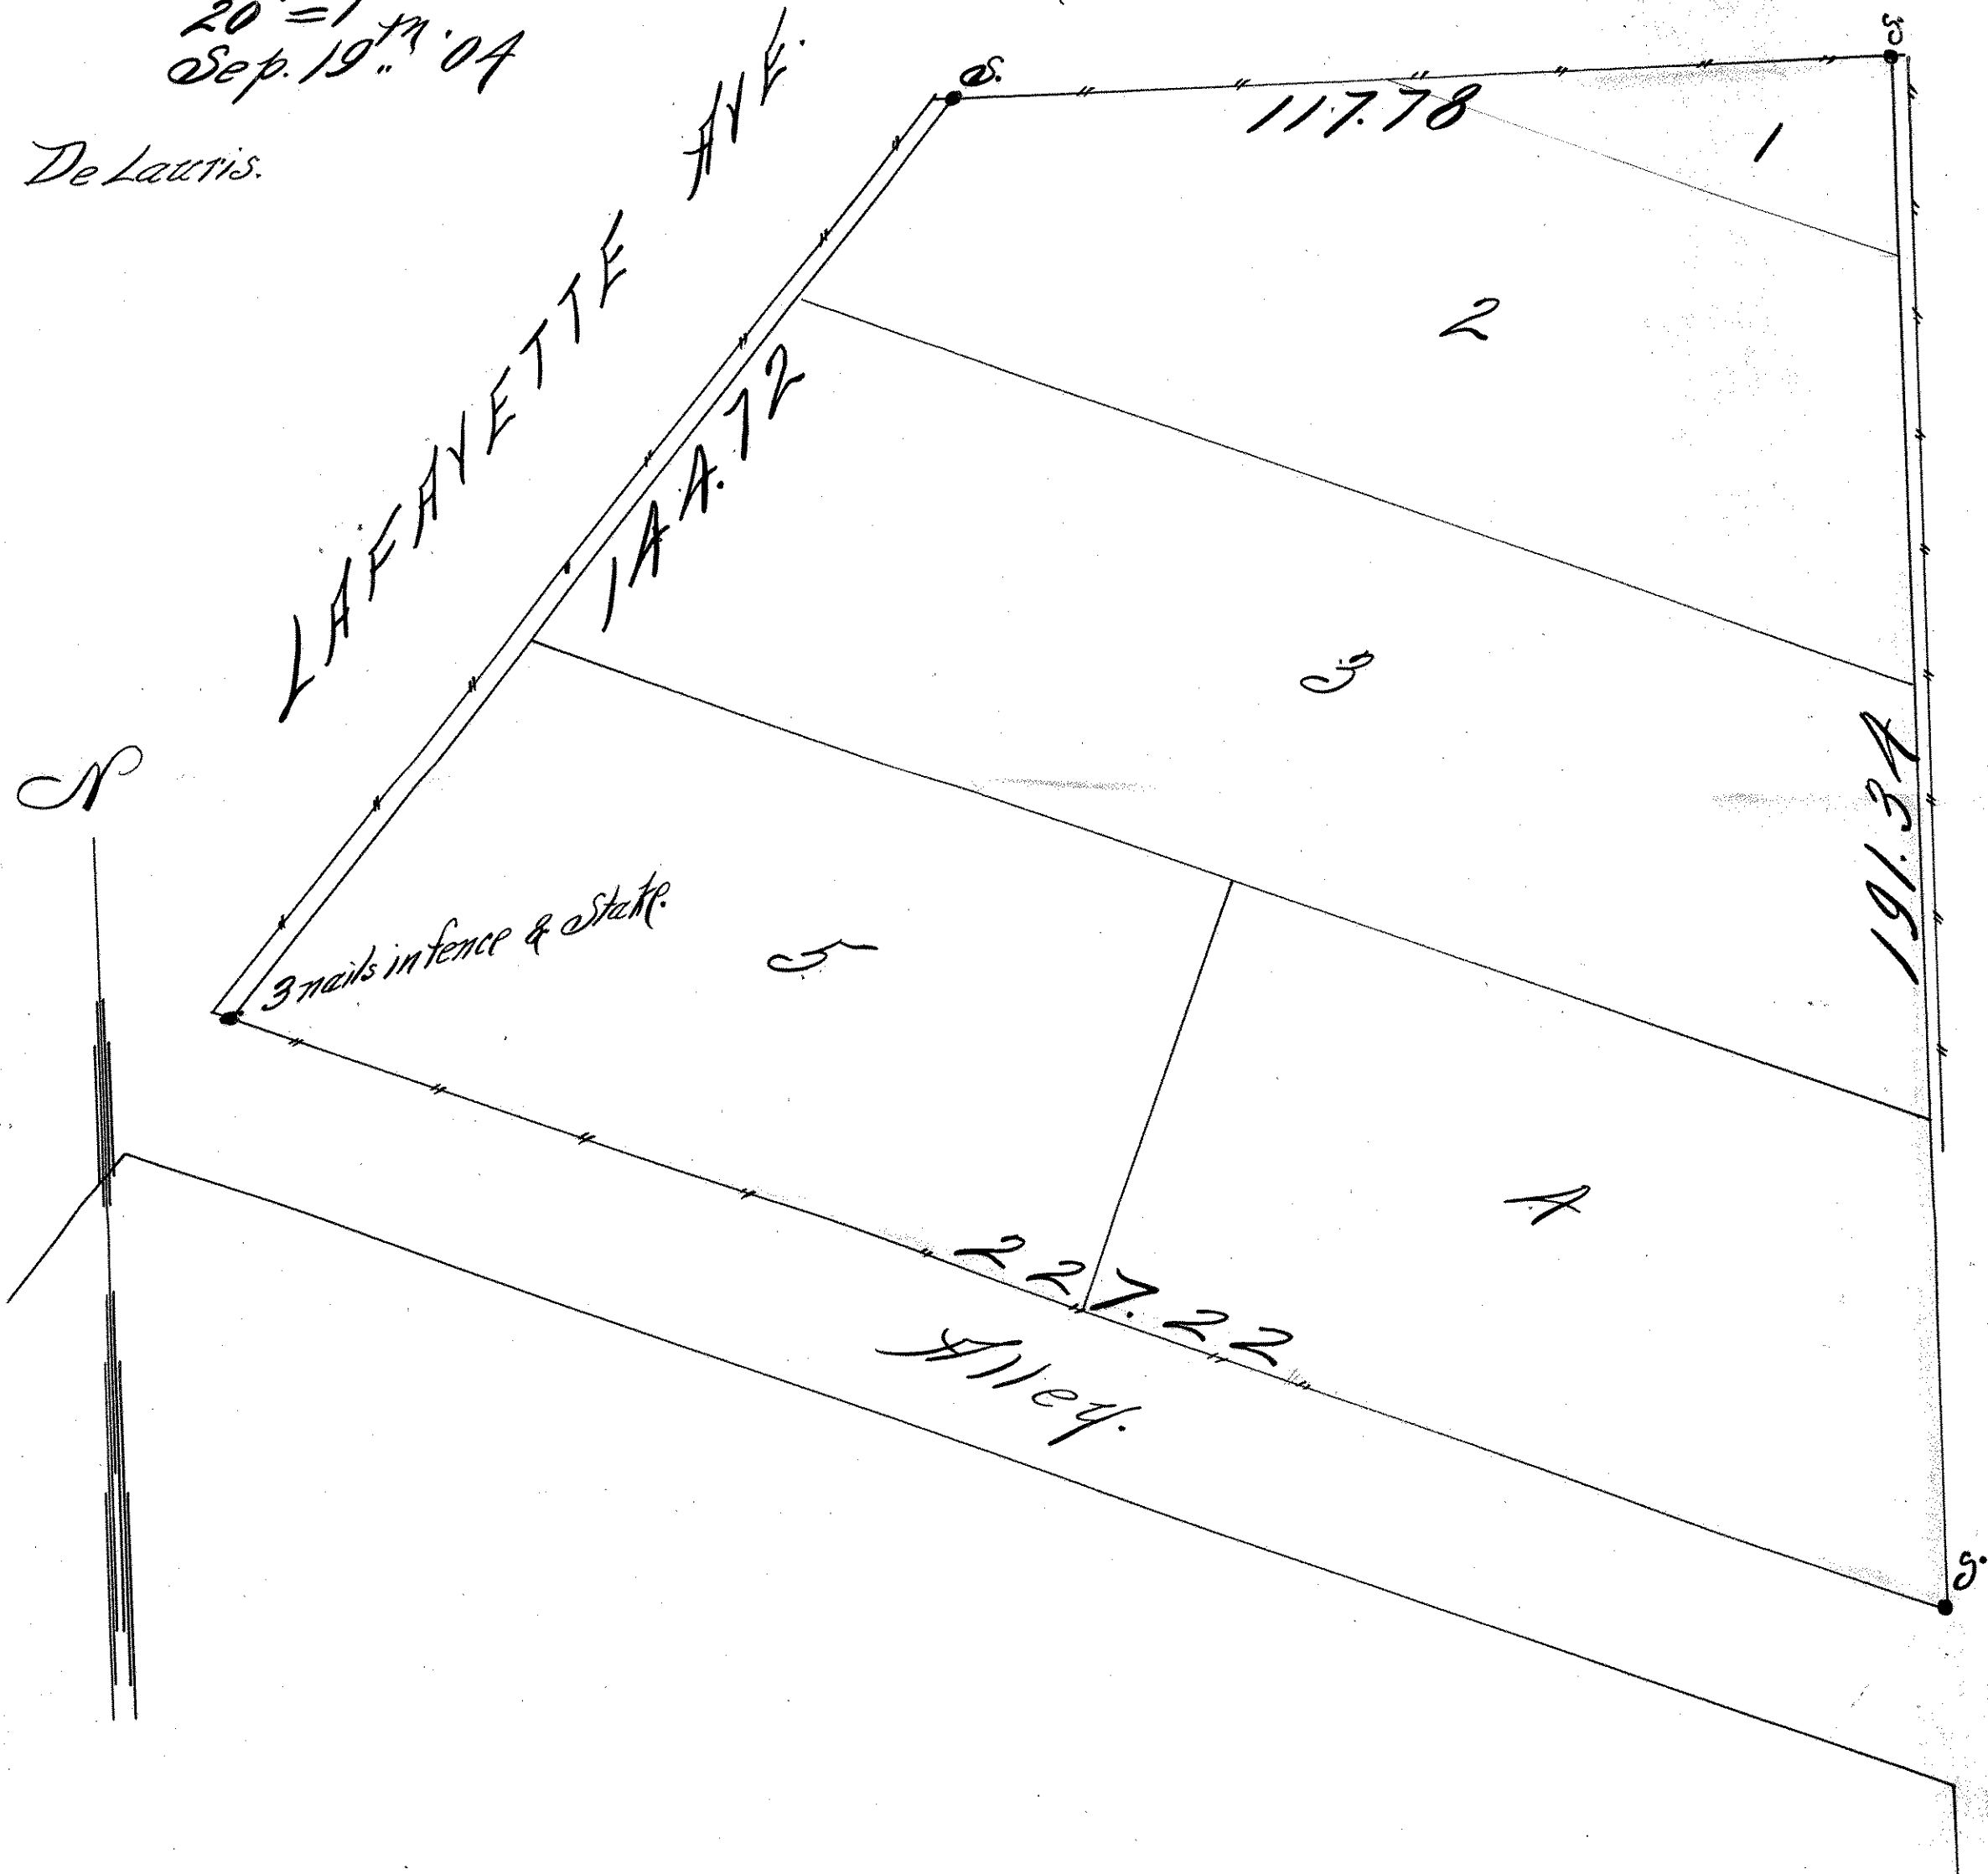

150

DE SOTO