


WEST 1/2 OF LOT 6 BLOCK 10 WARREN & WINSLOW'S ADD.
 Scale 10 feet pr. inch.

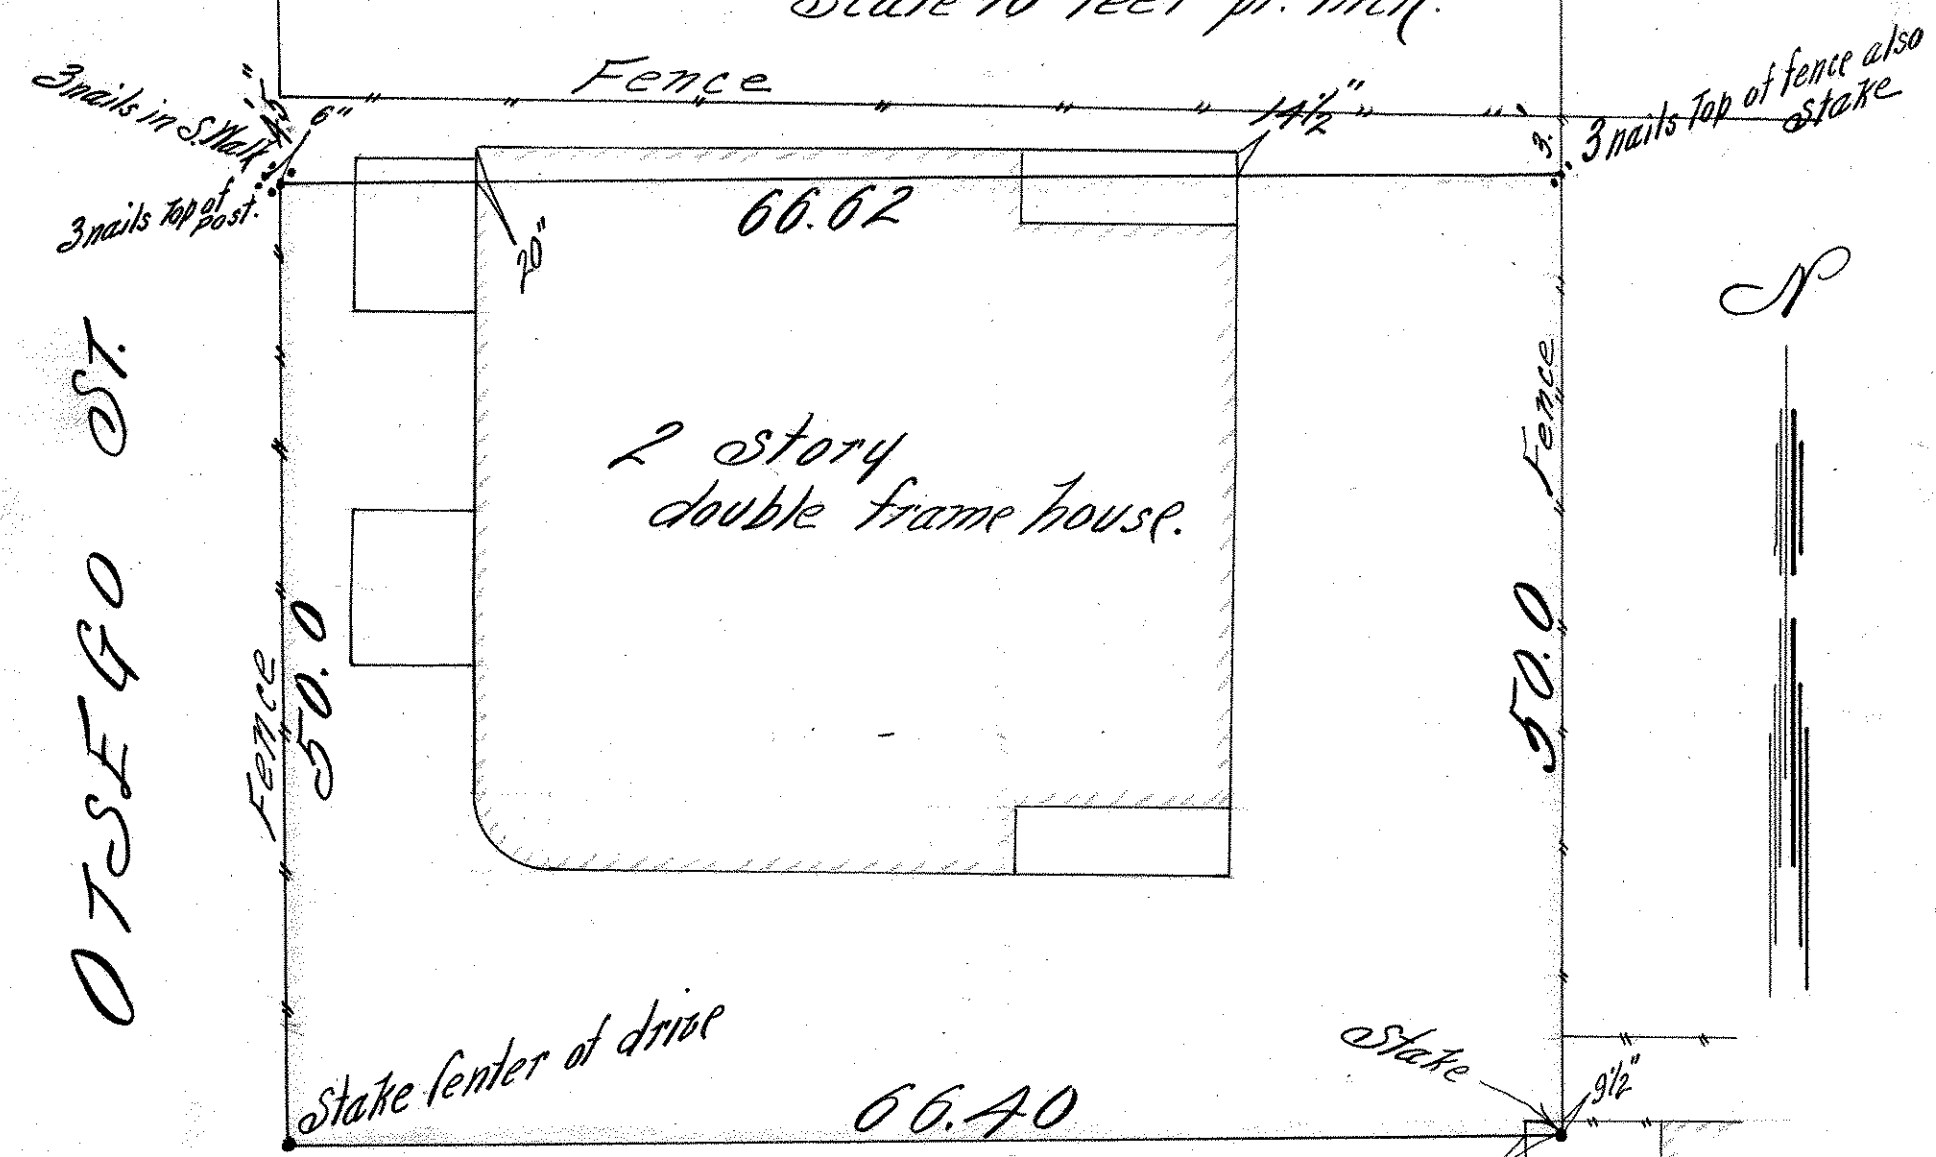

OTSEGO ST.

St. Paul Minn July 16th 1904
 I hereby certify that this diagram correctly represents
 "THE W. 1/2 OF LOT 6 BLK. 10 WARREN & WINSLOW'S ADD"
 as surveyed by me this day.

John B. Irvine
 County Surveyor Room 16 Court House.

E. J. Adams.