

WEST 1/2 LOT 13 BLOCK 8.
WARREN & WINSLOW'S ADD.

JOHN B. IRVINE, SURVEYOR.


408 GLOBE BLDG.

ST. PAUL, MINN.

APRIL 18-1913.

scale 20 ft. per. inch.

spikes in wall.

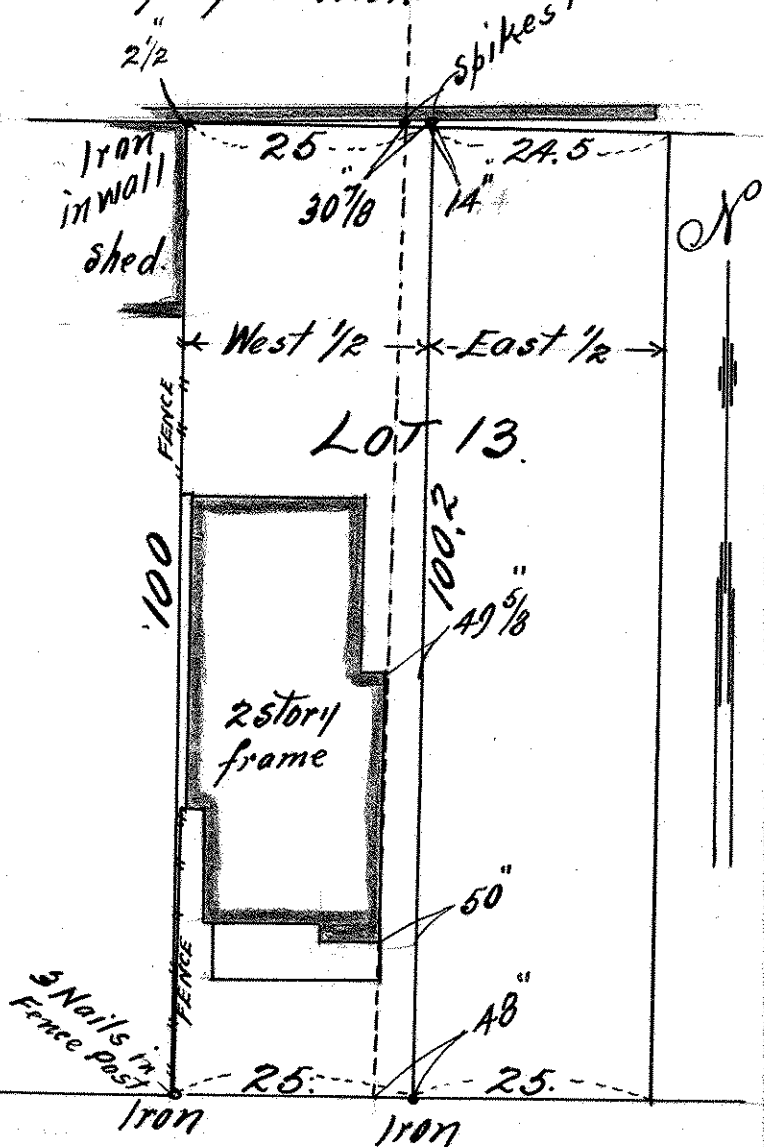

NOTION ST.