LOT 4 BLOCK 8.

WARREN & WINSLOWS ADD.

JOHN B. IRVINE. SURVEYOR
ST. PAUL MINN.
SEPT. 3 - 1908
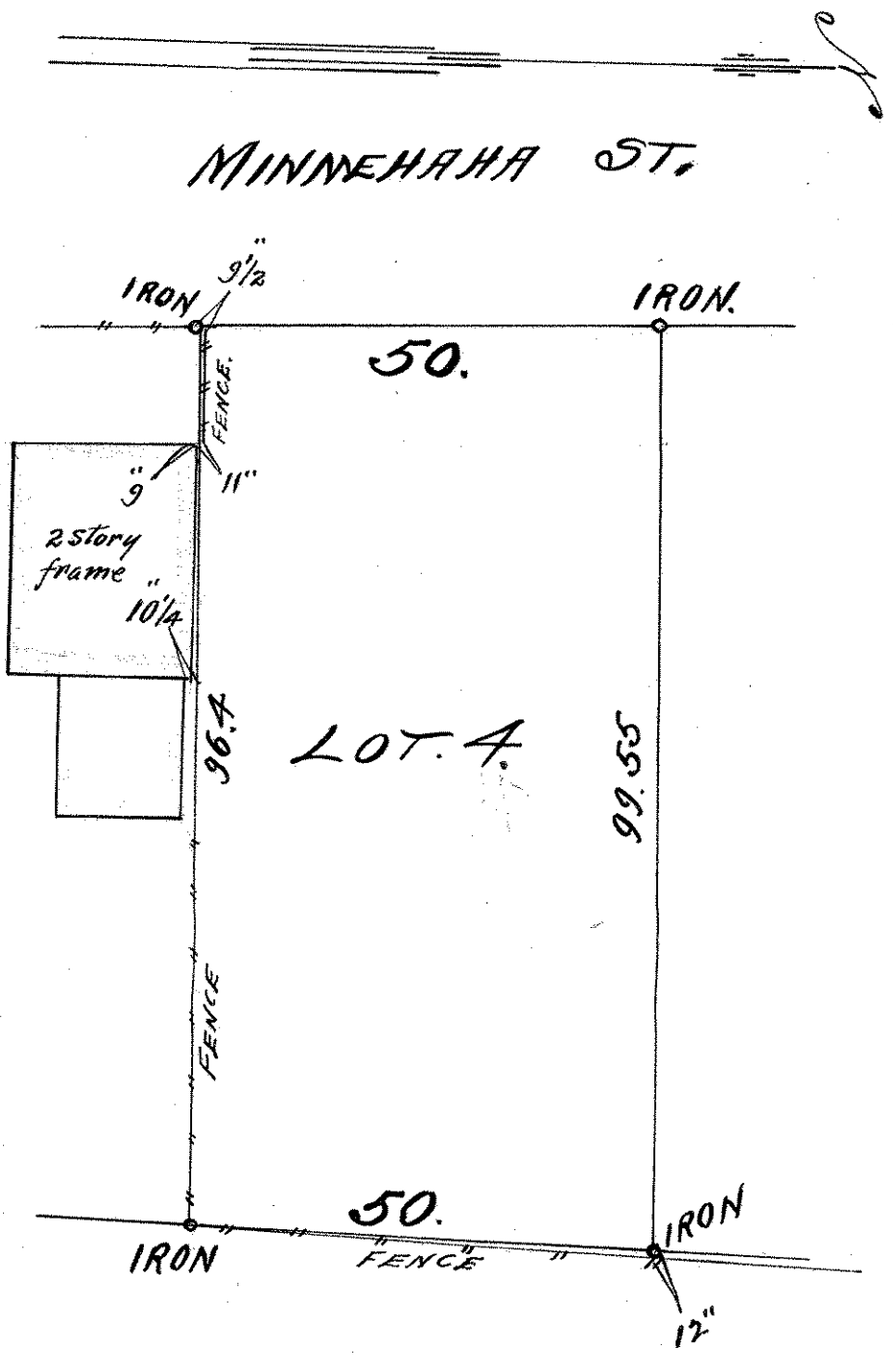
SCALE 20 ft. per inch.