


SURVEY OF ELY. LINE OF  
LOTS 1 & 15 BLK. 3  
WARREN & WINSLOW'S ADD.  
Dec. 13-1902 For R. M. Lawton

RANDALL ST. Iron

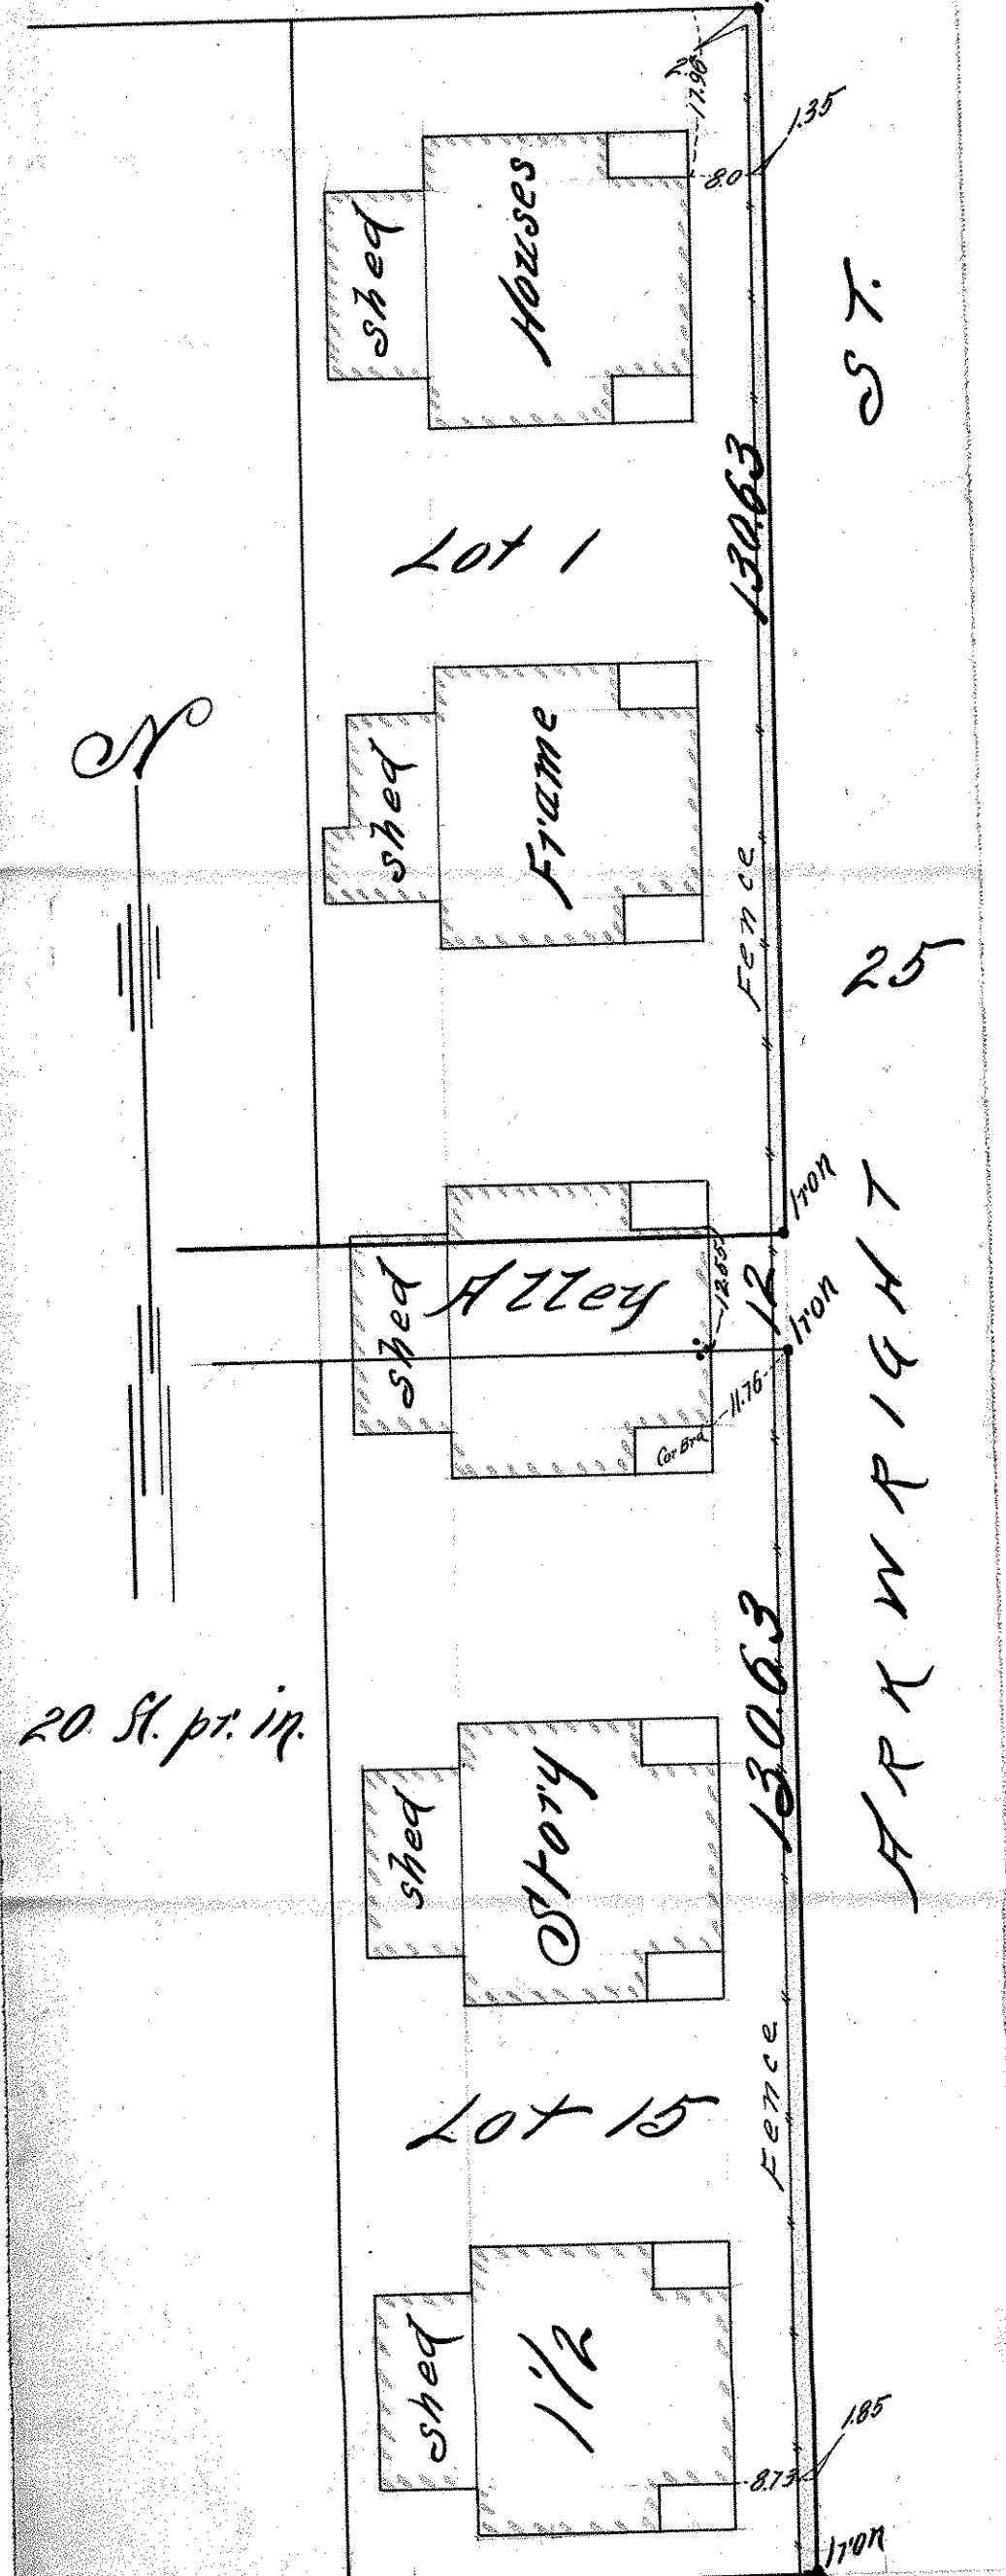

PENNSYLVANIA AVE.  
B. 53 743