

14-30-2

LOT 1.



Water's Rear. of Part of
Lots 5 & 6, Blk. 52.

White Bear.

John B. Irvine, Surveyor.

Aug 15-1903.

scale 10 f per inch.

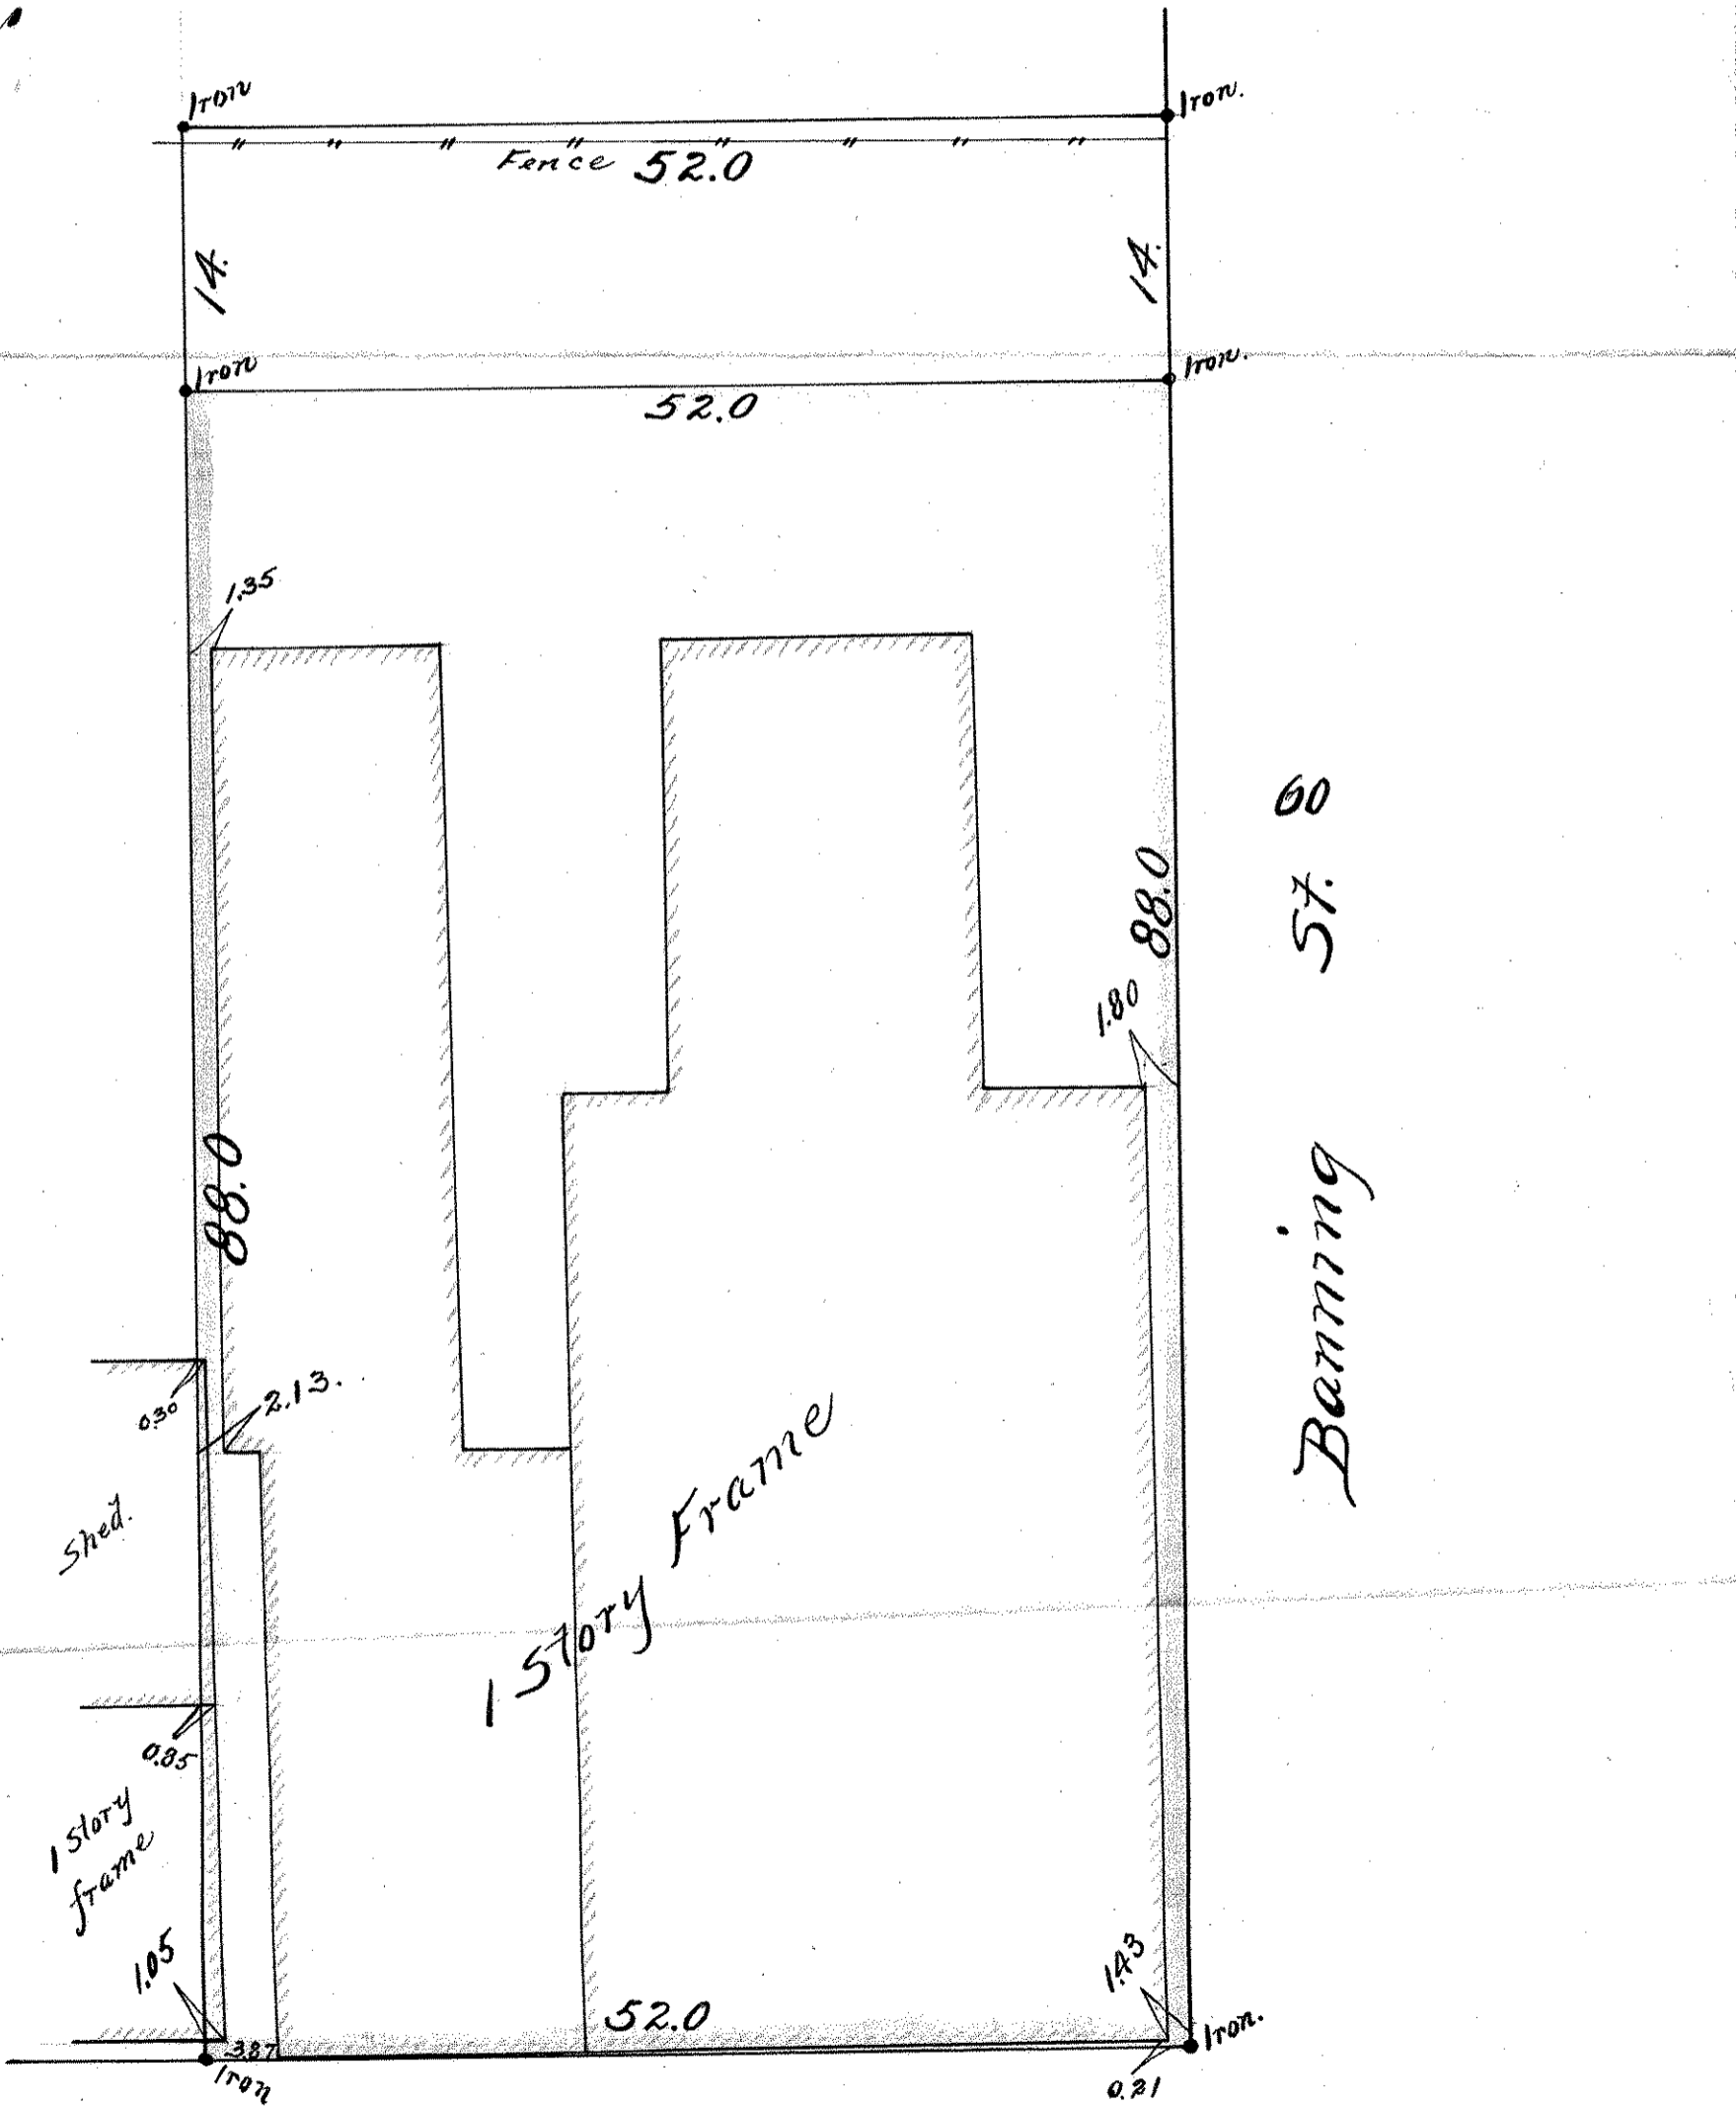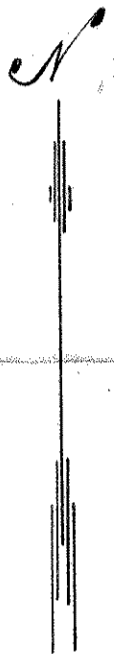

Banning St. 60

Banning

Fourth St. 60

Mary Stinson
White Bear