

14-30-2

# LOT 1.

Water's Rear. of Part of



Lots 5 & 6. Blk. 52.

White Bear.

John B. Irvine. Surveyor.

Aug 15-1903.

scale 10 f per inch.

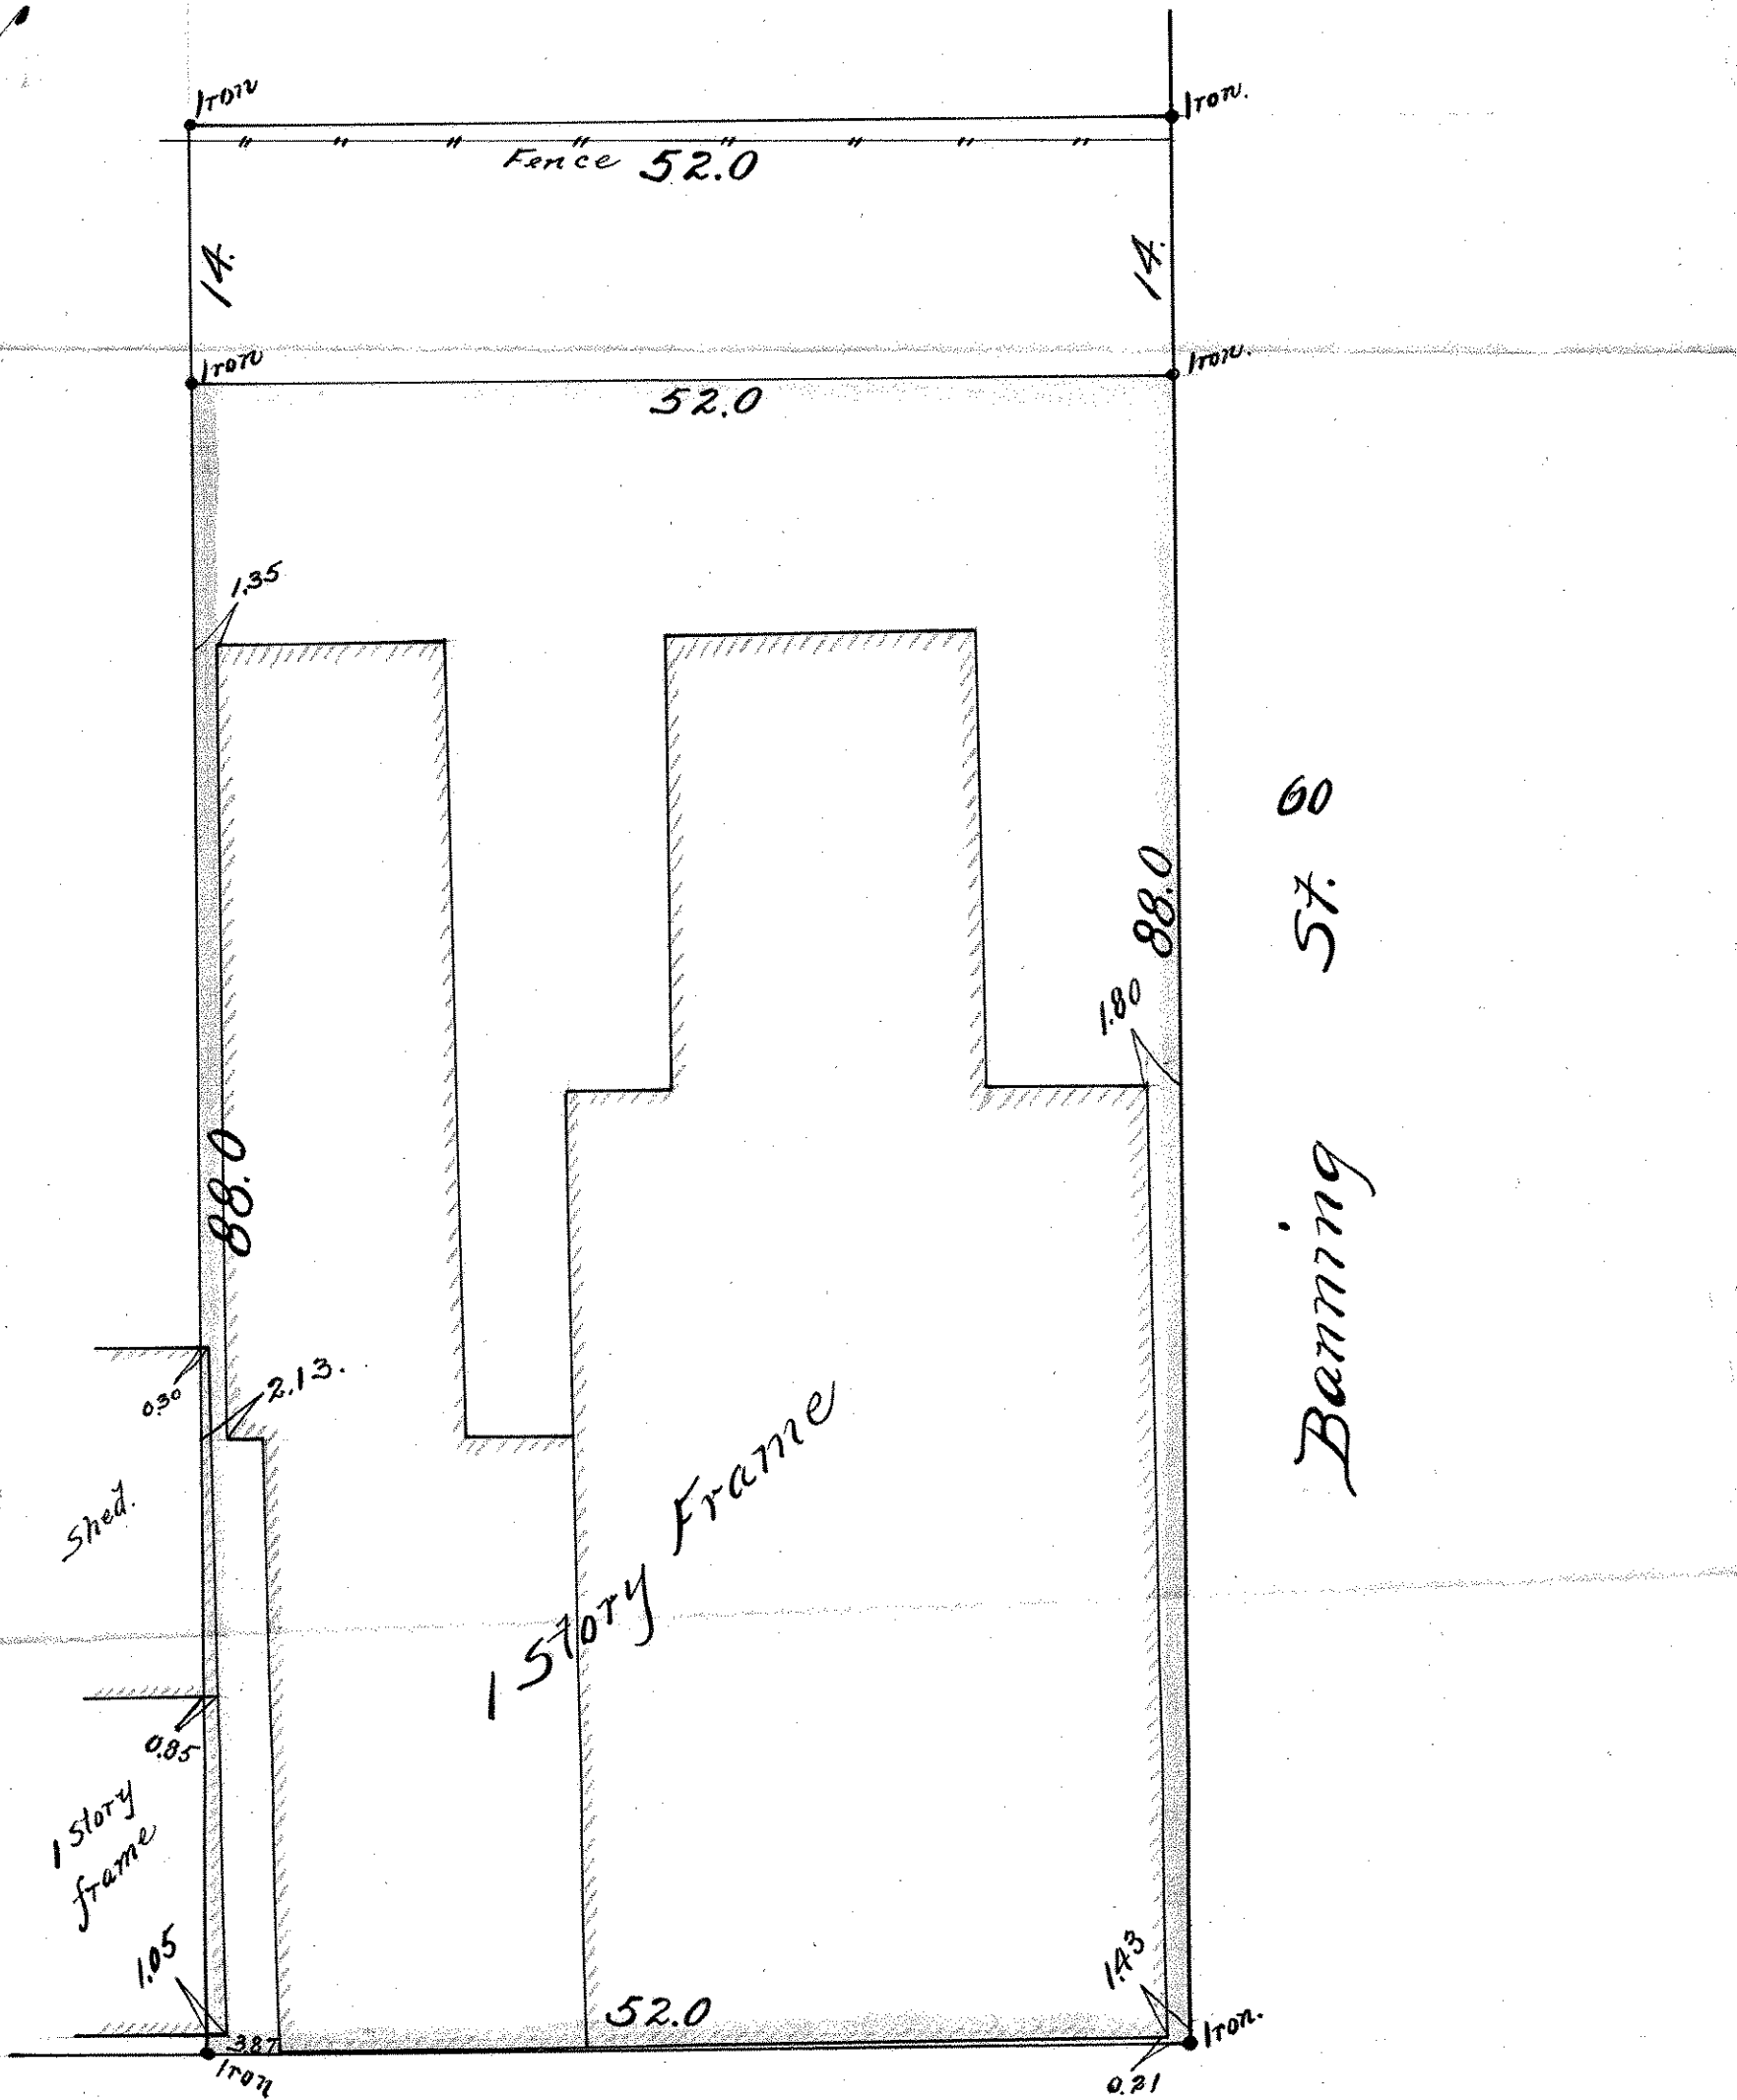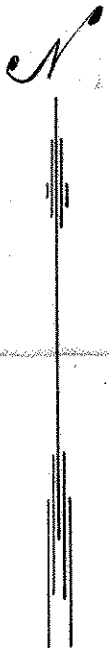

Fourth St. 60

Banning St. 60

Henry Blakewell  
White Bear