

WATSON & RICE'S SUB. A,


PART OF BLK. 3
RAMSEY'S ADD.

JOHN B. IRVINE, SURVEYOR.

ST. PAUL MINN.

APRIL 23-08.

SCALE 10 ft. per inch.

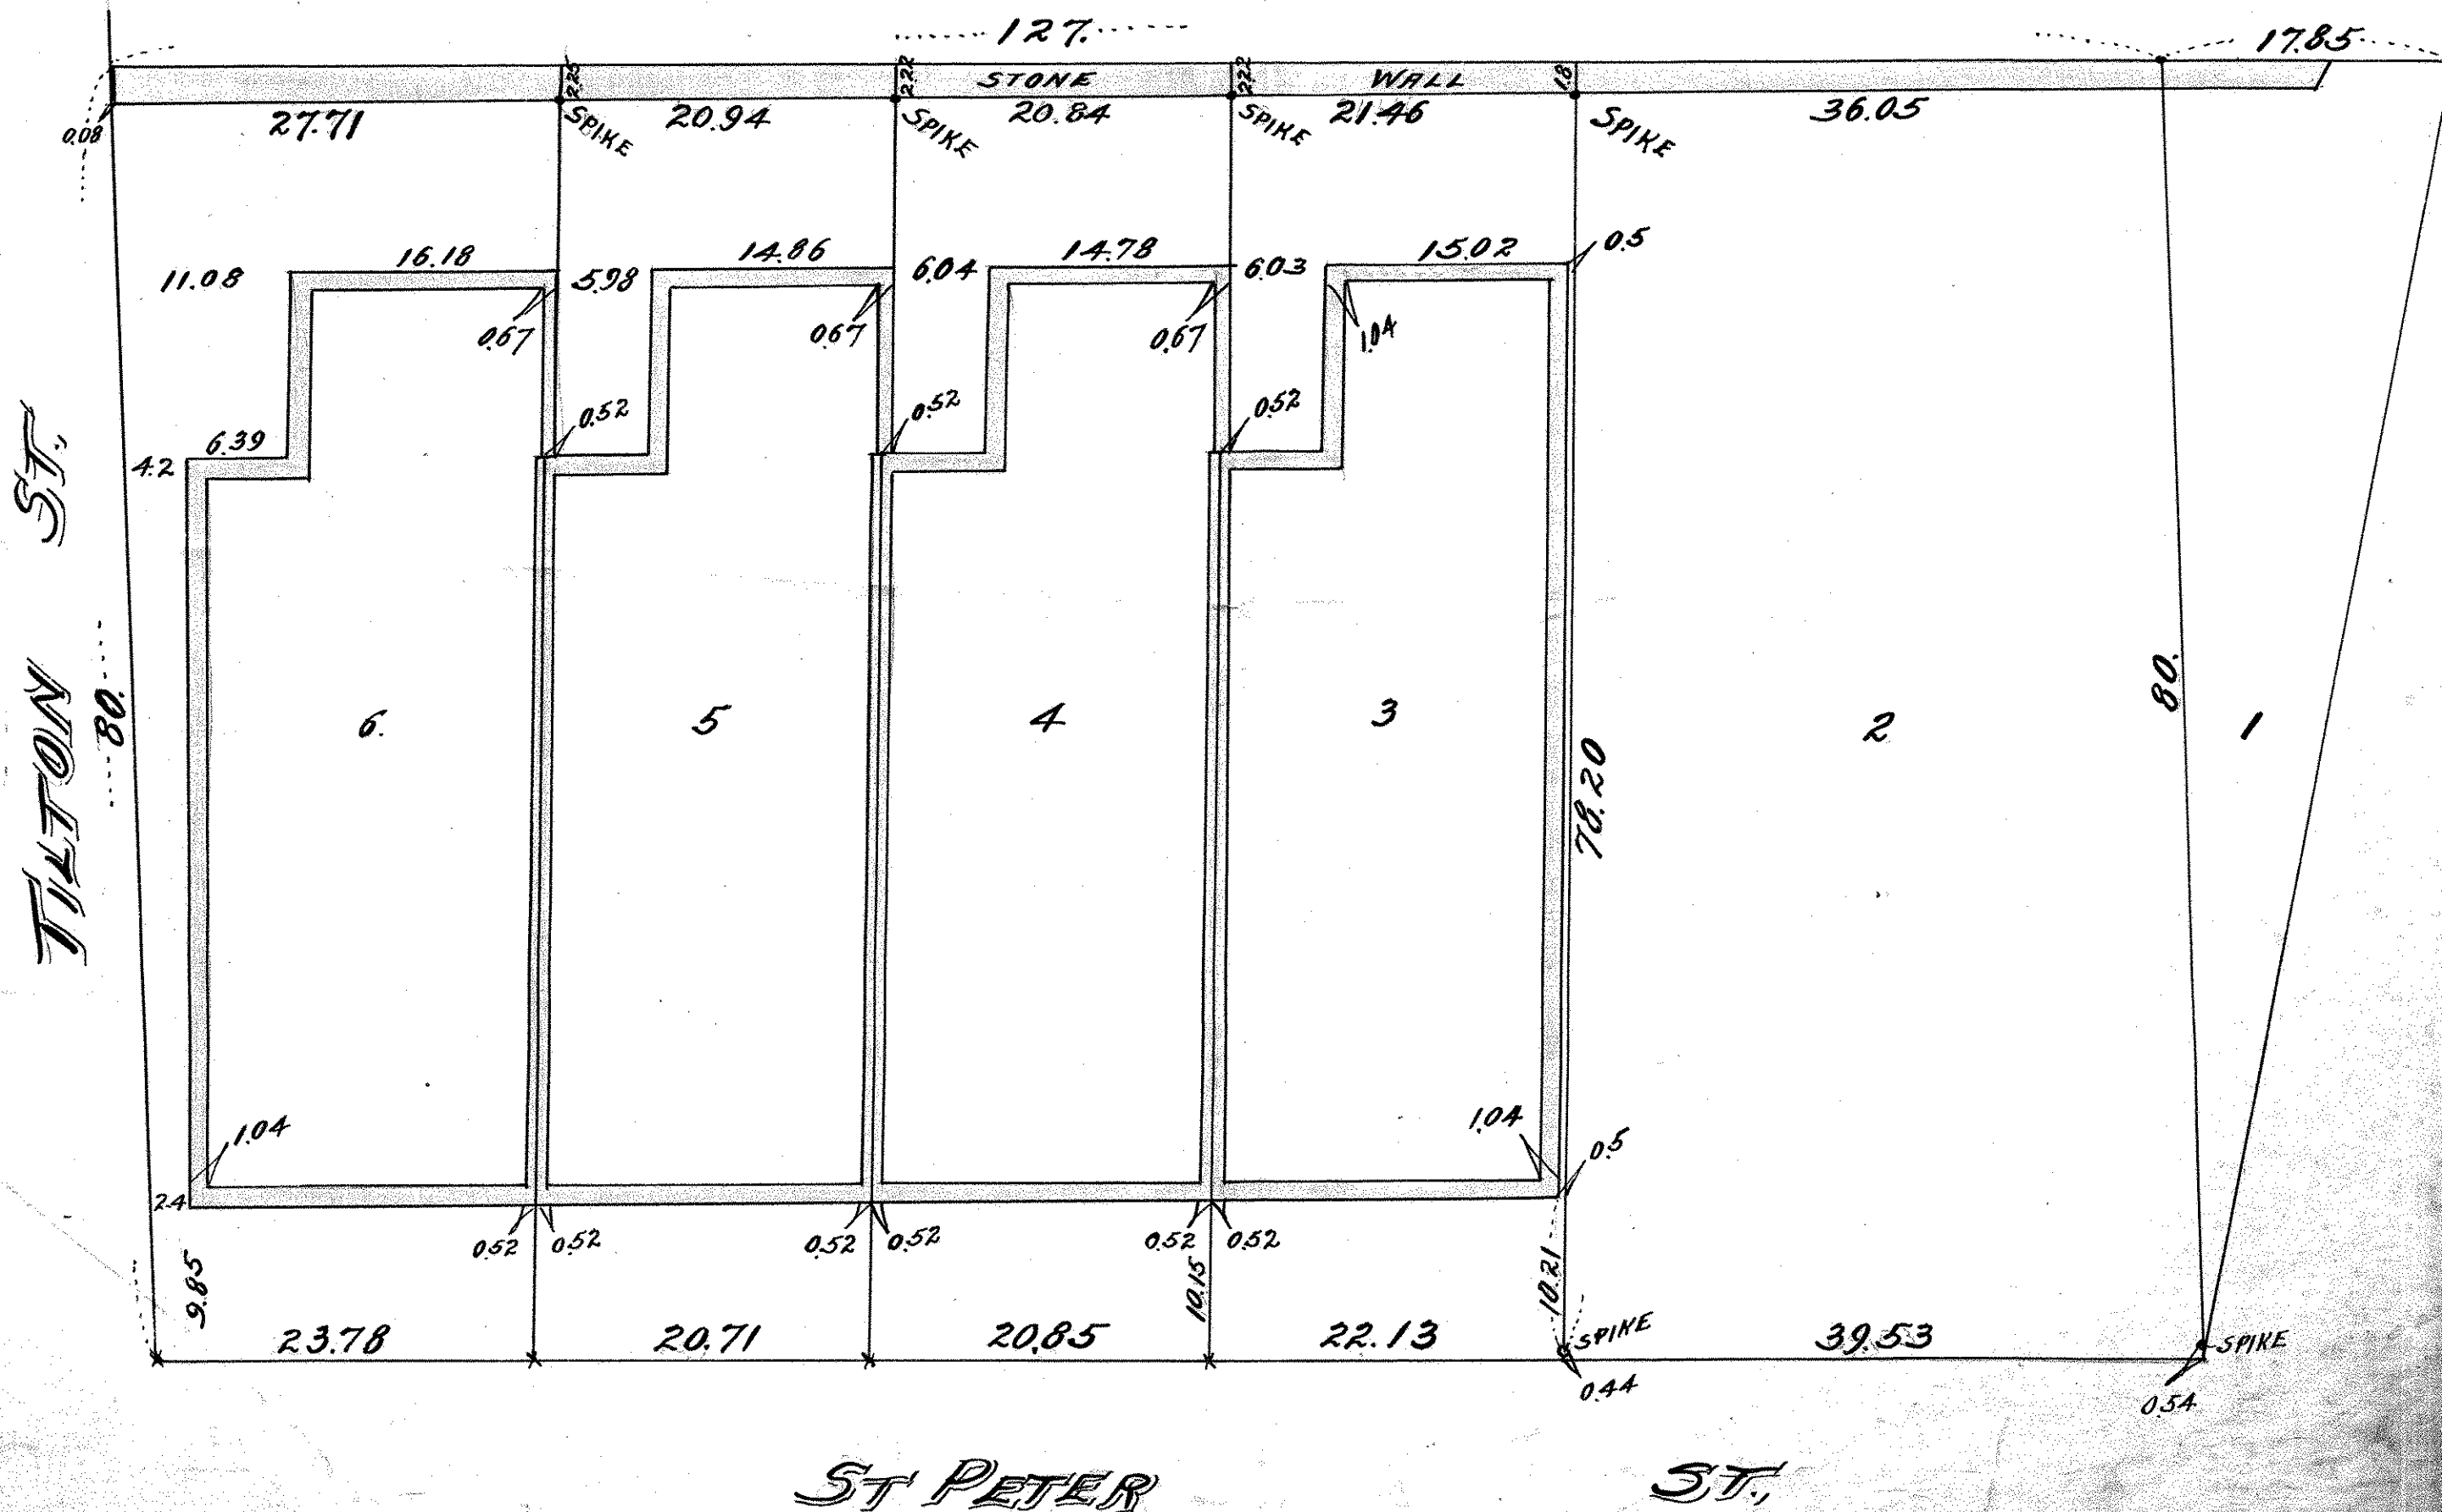

D.L.C. AUG. 26. 1882
R. of D. R. T.