

LOT 20 & LOT 21. EXCEPT EAST 29 ft.

WEED AND WILLIUS SUB.

BLOCK 23

WOODLAND PARK ADD.

JOHN B. IRVINE SURVEYOR.


416 GLOBE BLDG.

ST. PAUL MINN.

FEB. 21-07.

SCALE 20 ft. per inch.

N

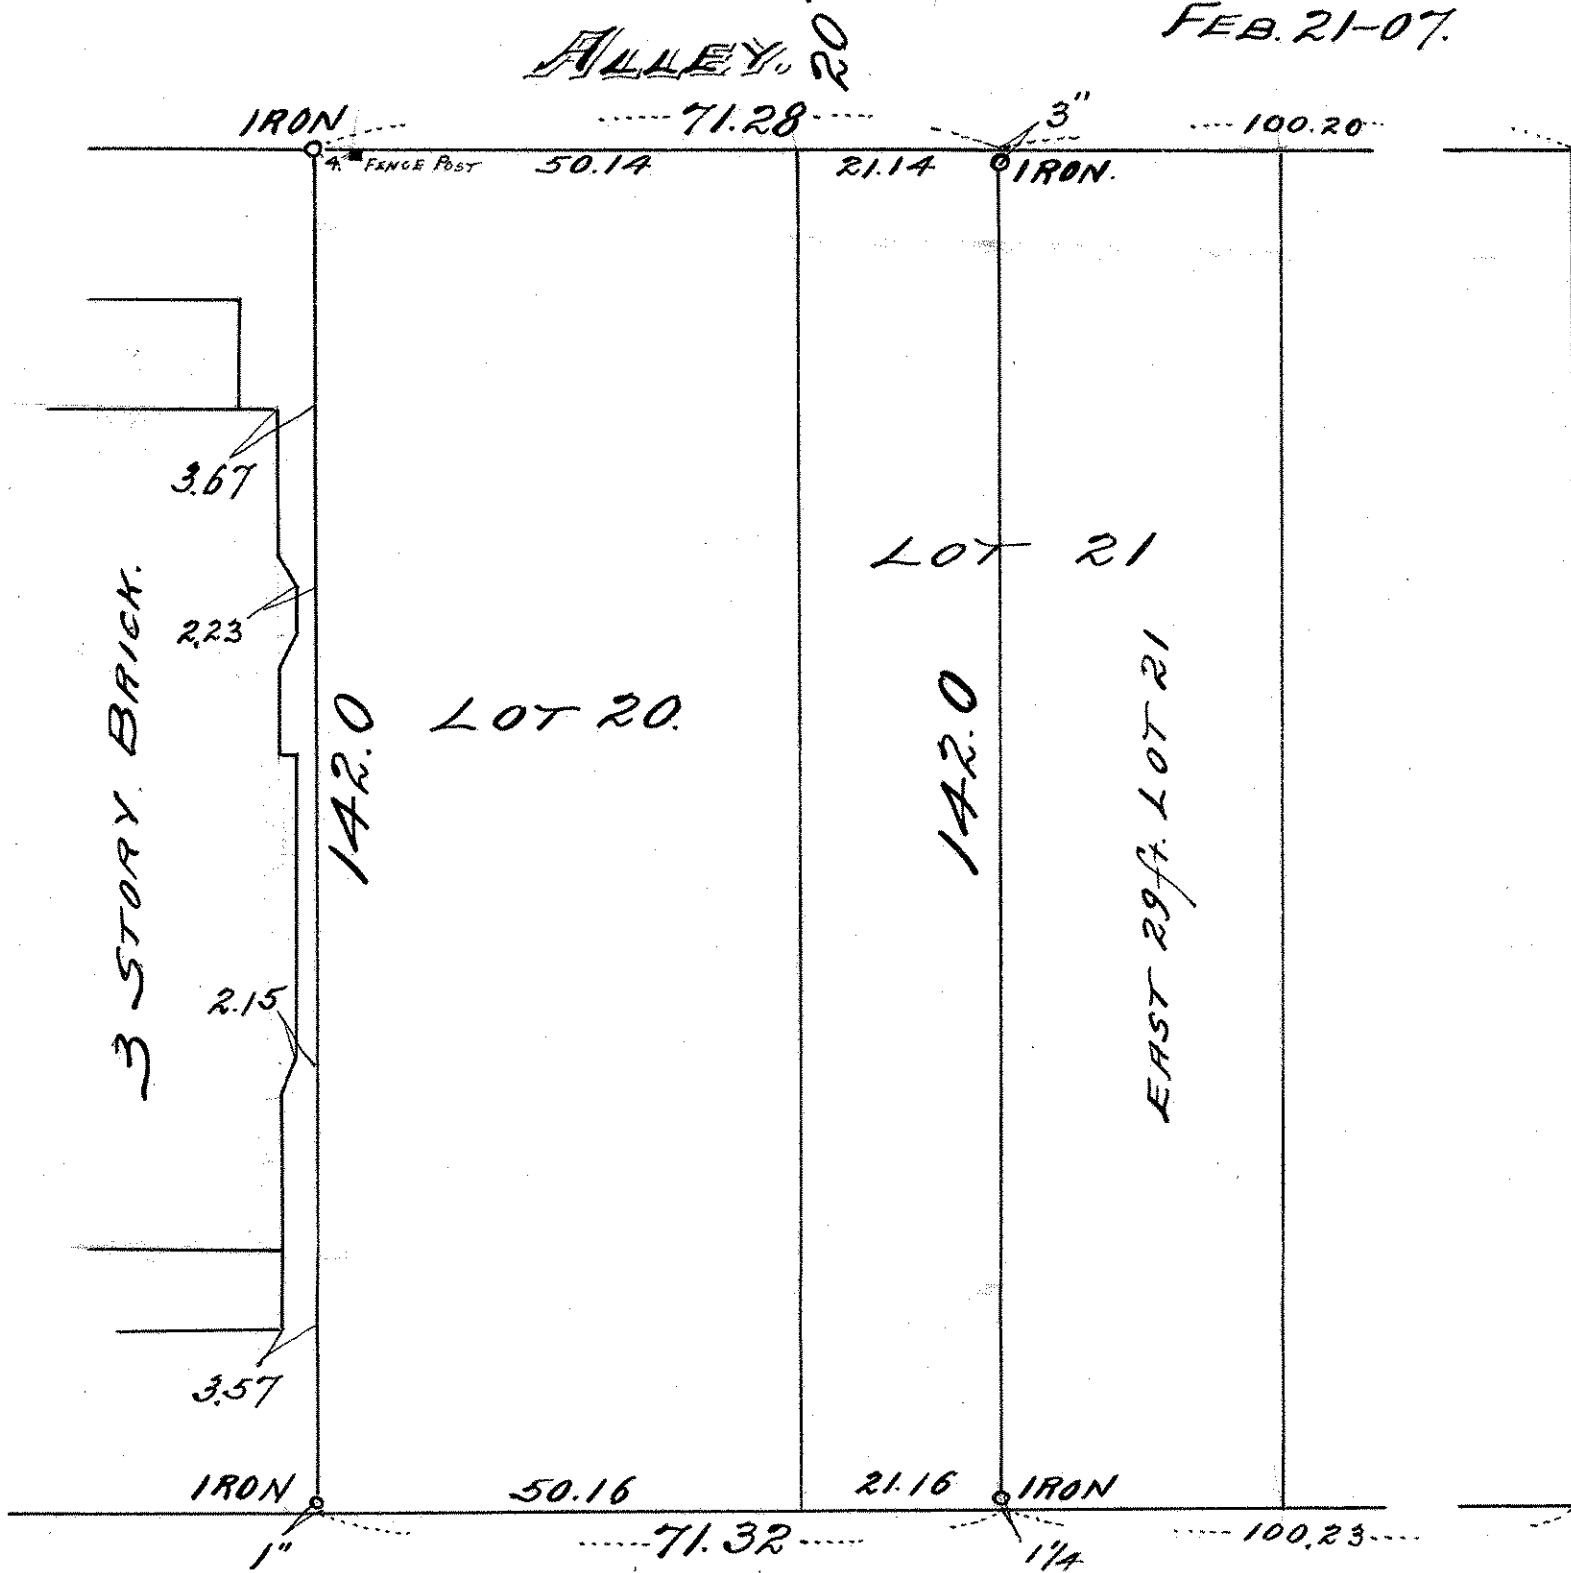

ST
EAST
66

SUMMIT AVE. 100