

LOTS 33, 34 & 35 BLOCK 1.
ROBERT L. WARE'S
EASTERN HEIGHTS,

JOHN B. IRVINE, SURVEYOR.


408 GLOBE BLDG.

ST. PAUL, MINN.

o = IRONS

MAY. 14-1917.

Scale 30ft. per inch

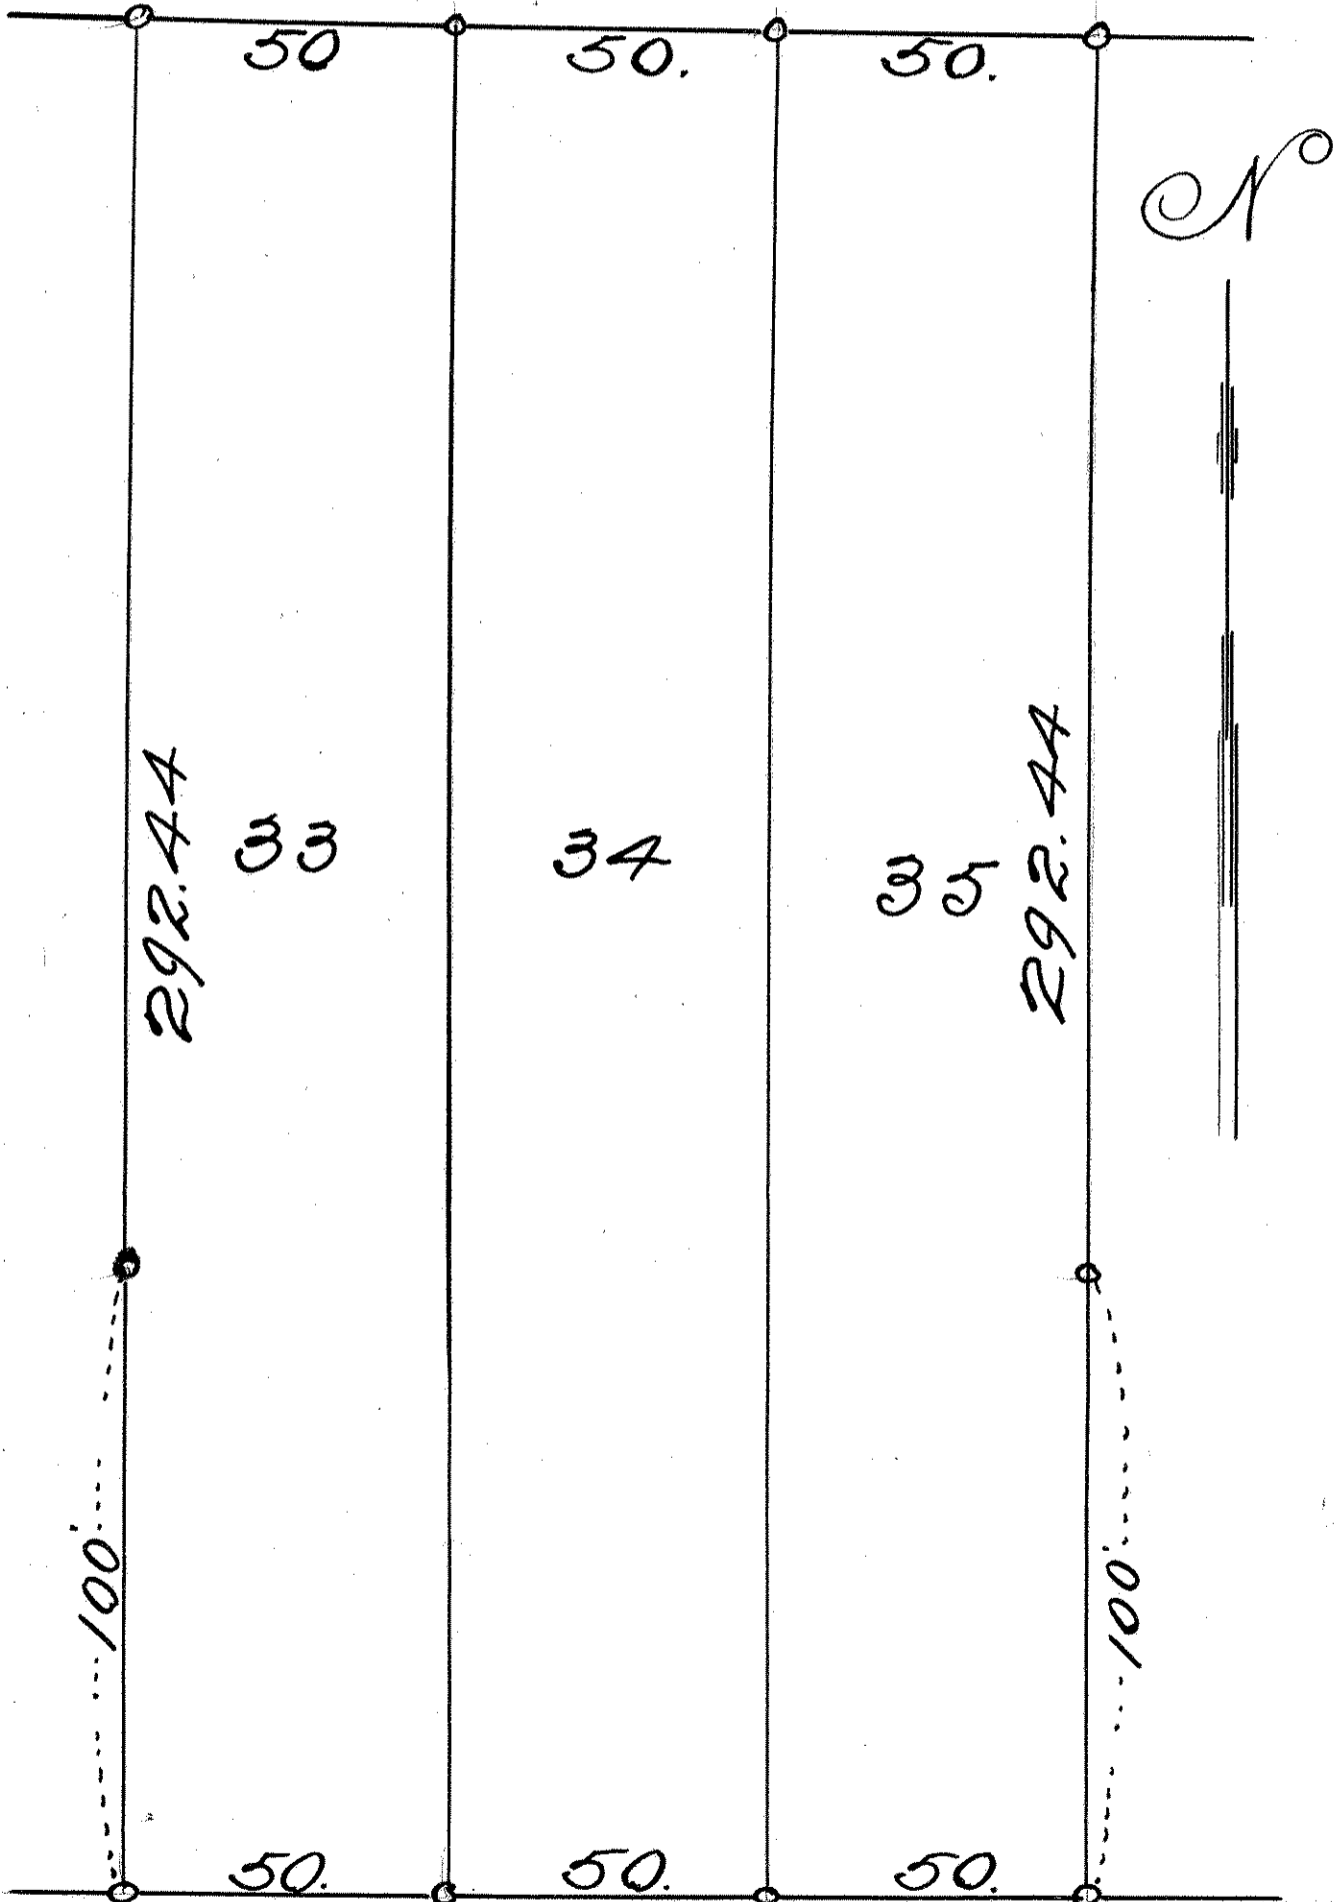

MARGARET ST.