

LOT 24 BLOCK 1.


WALTON'S SUNNY
SLOPE.

JOHN B. IRVINE, SURVEYOR.

ST. PAUL, MINN.

OCT. 26. - 1916.

Scale. 20ft. per inch.

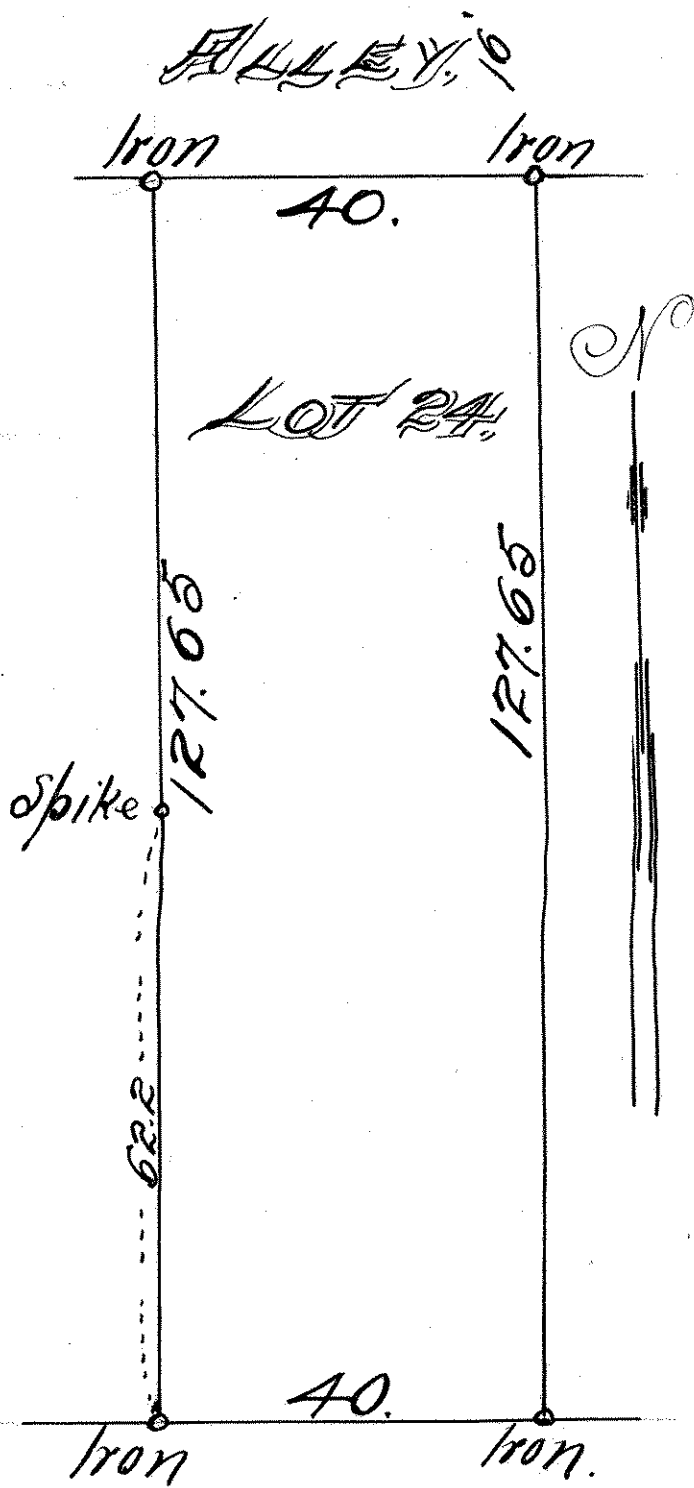

SARGENT FIVE.