


LOTS 26 & 27 BLOCK 5
WANN'S ADD.

JOHN B. IRVINE, SURVEYOR.
416 GLOBE BLDG.
ST PAUL MINN.
MAY 4-07.

SCALE 20ft. per inch.

ALLEY, 20

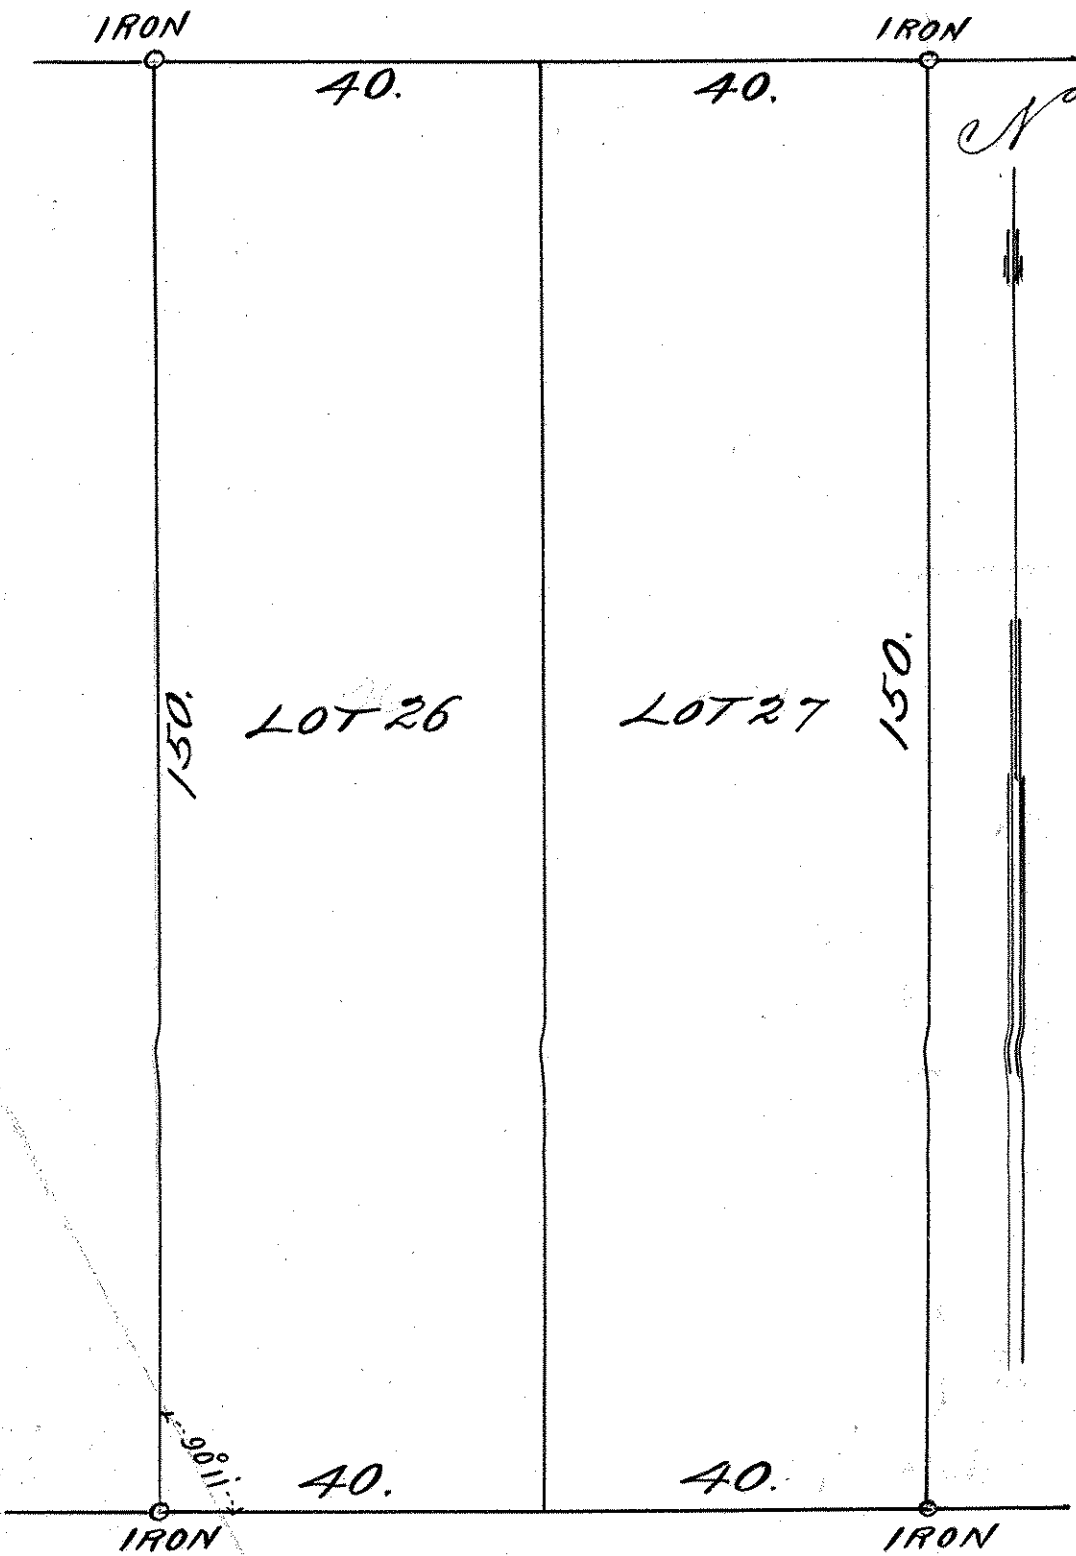

66 LINCOLN AVE.