

LOT 27 BLOCK 3


WANN'S ADD.

John B. Irvine Surveyor

St. Paul. Minn.

Aug. 21-1919.

Scale 20 ft. per inch.

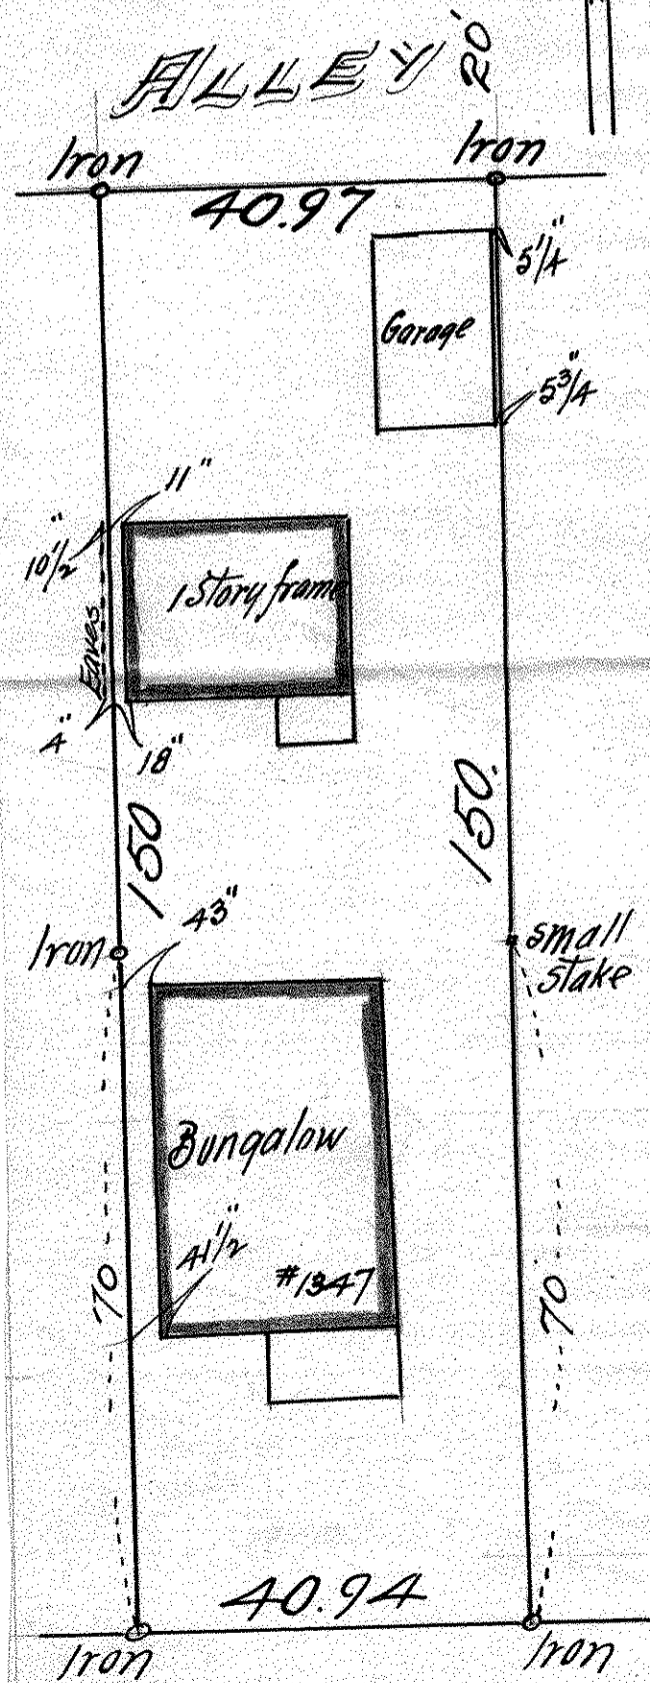

GOODRICH AVE.