


LOT 1 BLOCK 2
JOHN WARD'S ADD.
SURT. Mar. 26th 1903 For
20 Feet pr. inch

66 EDMUND ST.

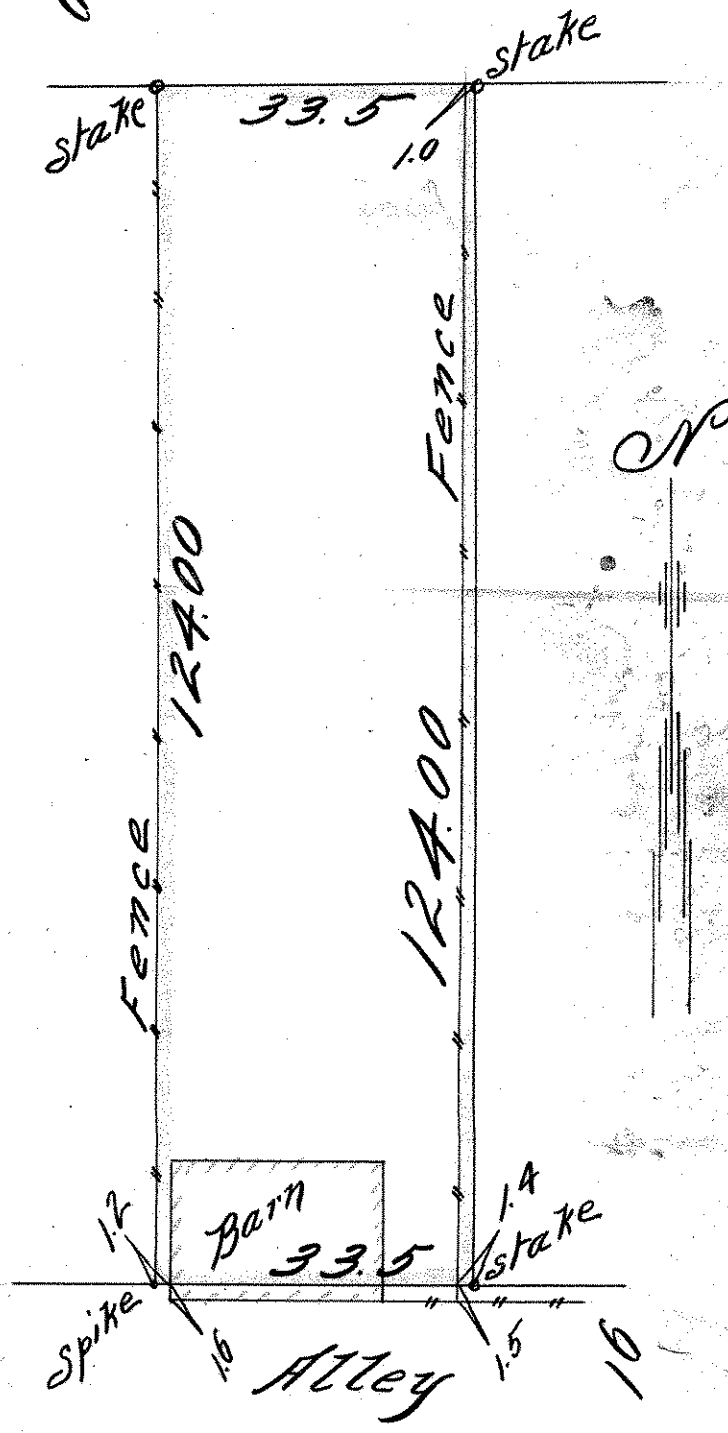

B.53.P.74.