


LOT 27 BLOCK 1
ELLA M. WARREN'S SUB'D,
BLOCK 3.

ROGERS & HENDRICKS
OUTLOTS

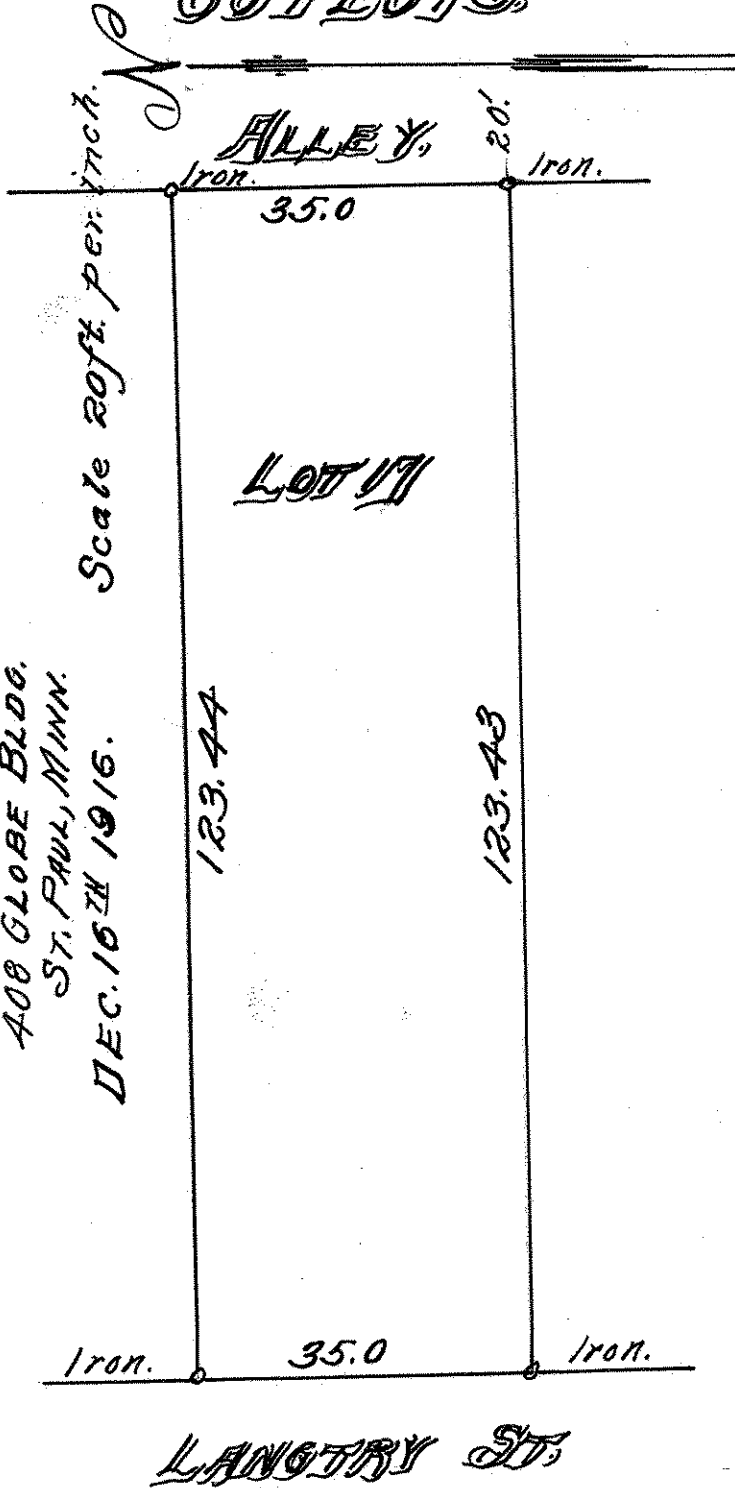

JOHN B. IRYINE, SURVEYOR.
408 GLOBE BLDG.
ST. PAUL, MINN.
DEC. 16TH 1916.