

LOTS 11 & 12 BLOCK 24.

WEST ST. PAUL, REAL ESTATE &  
IMPROVEMENT SYNDICATE ADD,  
No. 2.


JOHN B. IRVINE, SURVEYOR.

ST. PAUL, MINN.

4/19/13

scale. 20 ft per inch.

GATES ST.

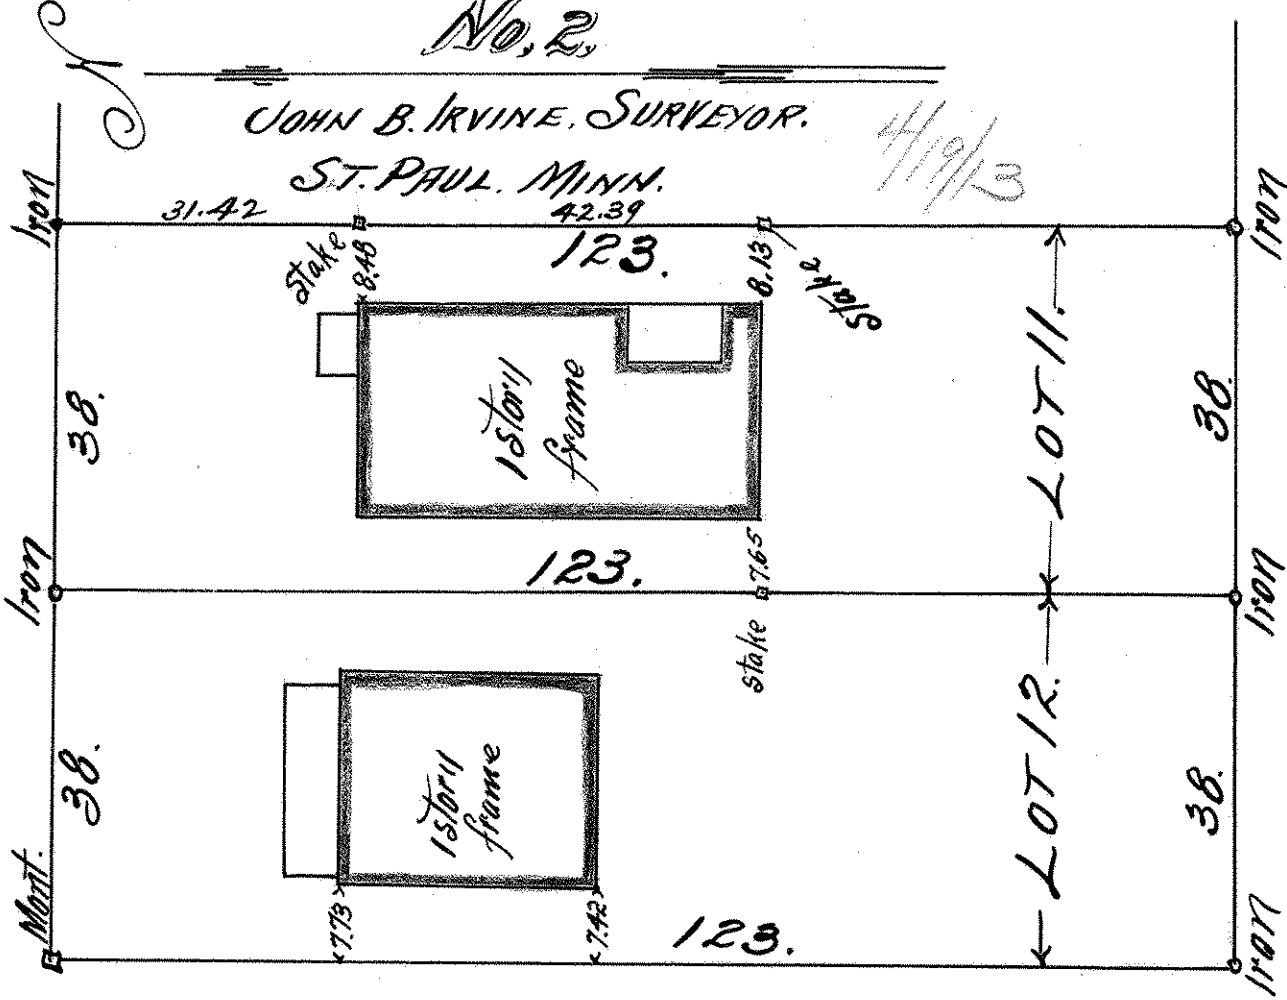

ANDREW

ST.

NO CHANGE

ALLEY 20.