

LOT 7, BLK. 28.

THE W. ST. PAUL REAL ESTATE
AND

IMPROVEMENT SYNDICATE ADD.


No. 2

JOHN B. IRVINE, SURVEYOR.

ST. PAUL MINN.

MCH. 2⁵ 1908.

Scale 20ft. per inch.

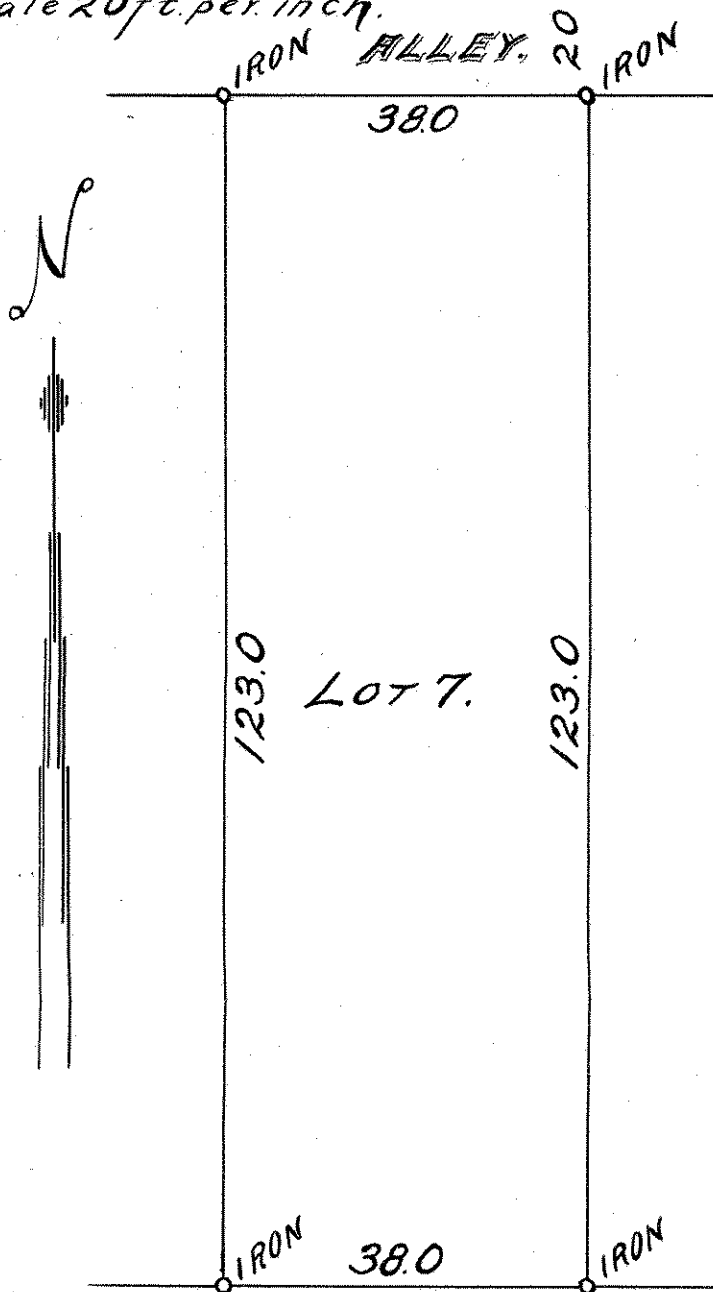

E. BELVIDERE ST. 60

MARCH 1908