

LOT 2 & SOUTH 1/2 LOT 1  
BLOCK 12.

W. ST. P. R. E. & IMP'T SYND.  
No. 1, No


JOHN B. IRVINE, SURVEYOR.

408 GLOBE BLDG.

ST. PAUL, MINN.

JUNE 5th 1914

CURTICE ST.

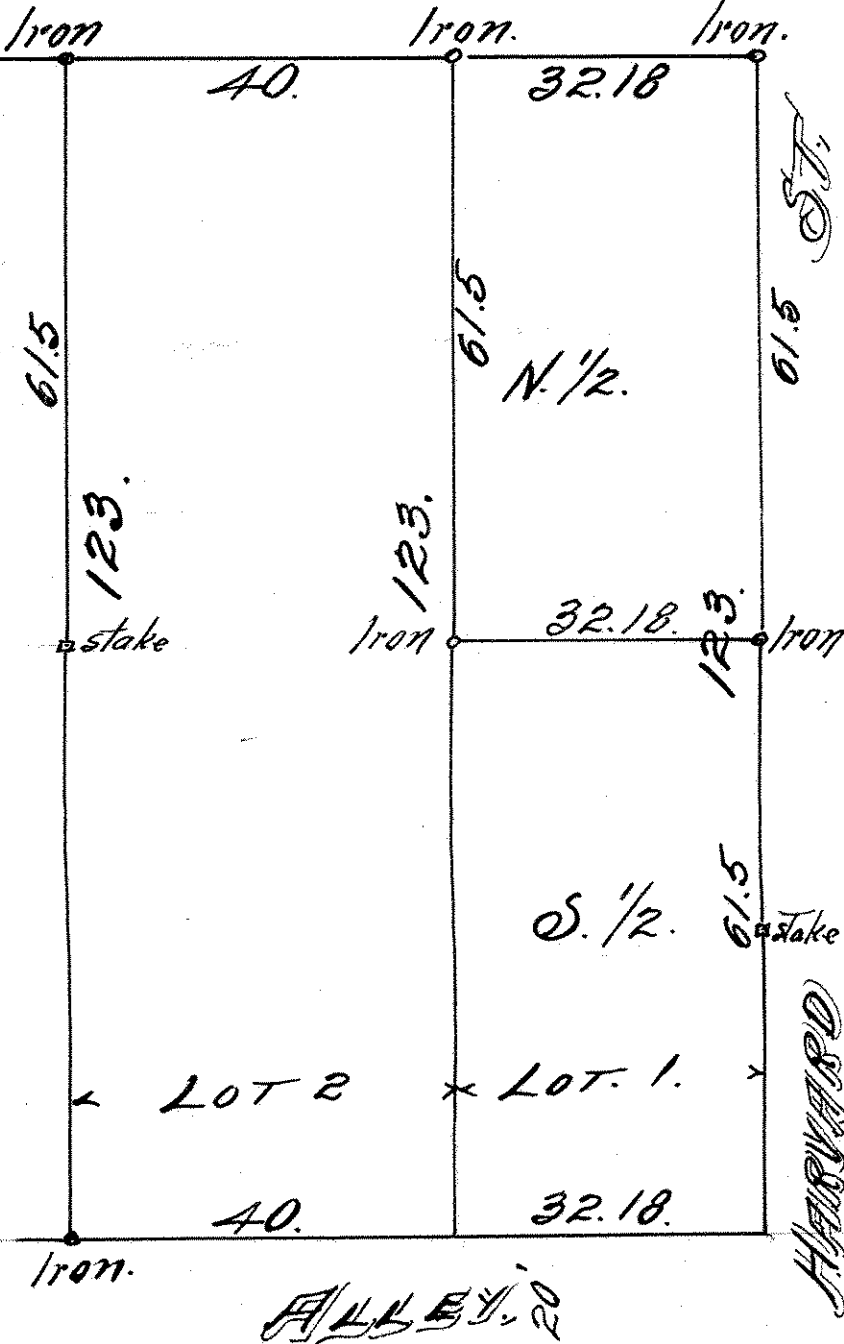

NO. 123