


LOTS 12, 13 & 16 BLOCK 1 THE W. ST. PAUL RE.
EST. & IMP. SYNDICATE ADD. No. 1
SUR. MAP. 1ATH 1903 FOR MRS. LA ROGUE

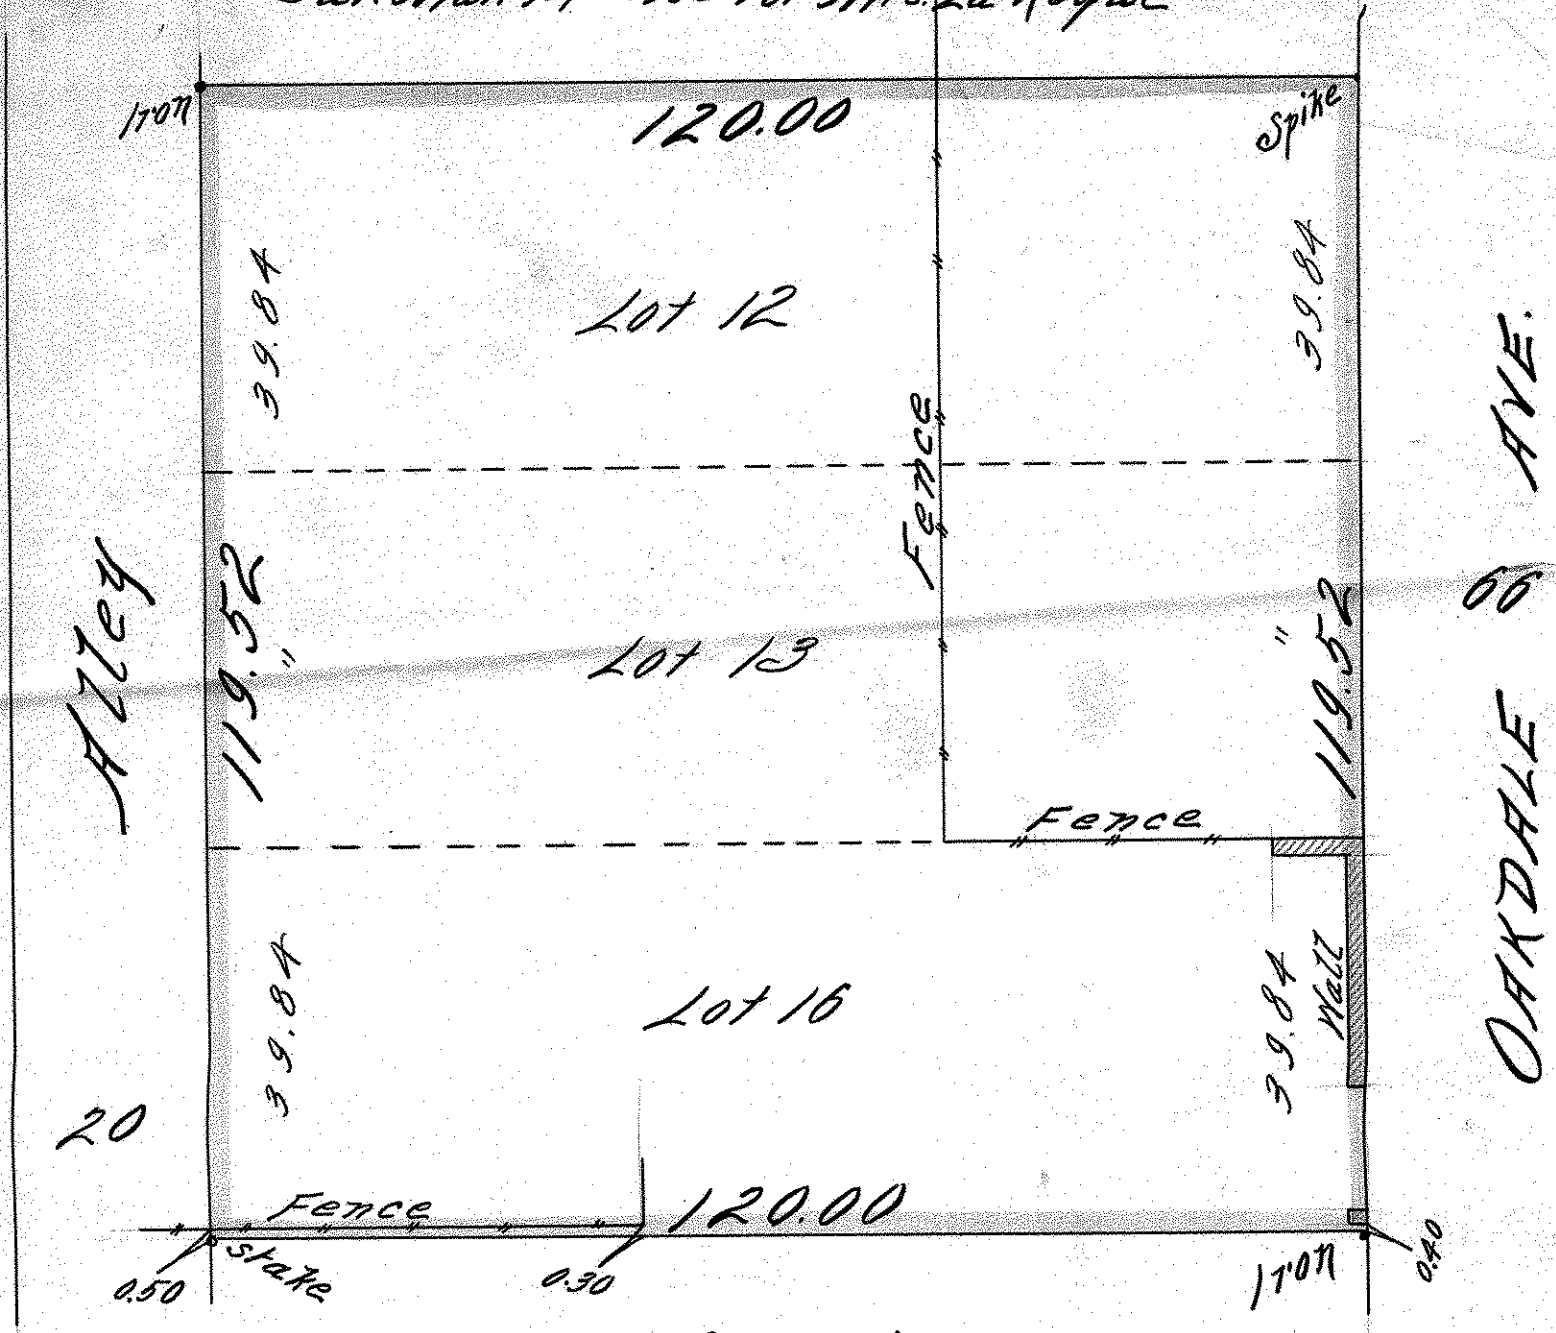

Scale 20 feet per inch

B53 P. 62

