LOTS 12 & 13.
CHAS WEIDE'S
SUB'N BLK. 45.
ARLINGTON HILLS
ADDITION.
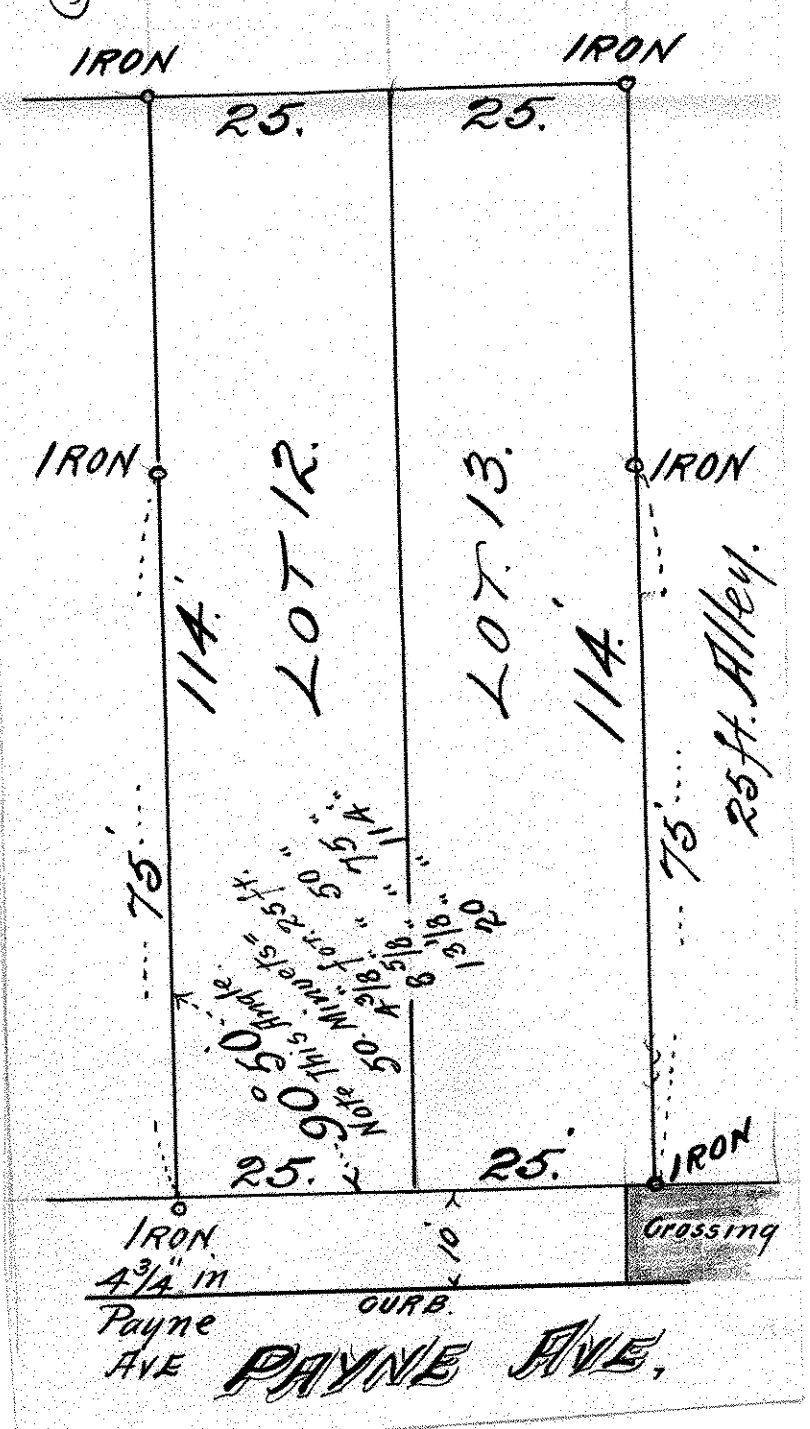
JOHN B. IRVINE, SURVEYOR.
408 GLOBE BLD'G.
ST. PAUL, MINN
APRIL 19-1911.
SCALE 20 ft. per. inch.