

LOTS 12 & 13 C. WEIDES

SUB. OF BLOCK 45.

ARLINGTON HILLS ADD.


JOHN B. IRVINE. SURVEYOR.

ROOM 406. GLOBE BLDG.

ST. PAUL MINN.

SCALE 1 IN. = 20 FT.

SEPT. 2 - 05

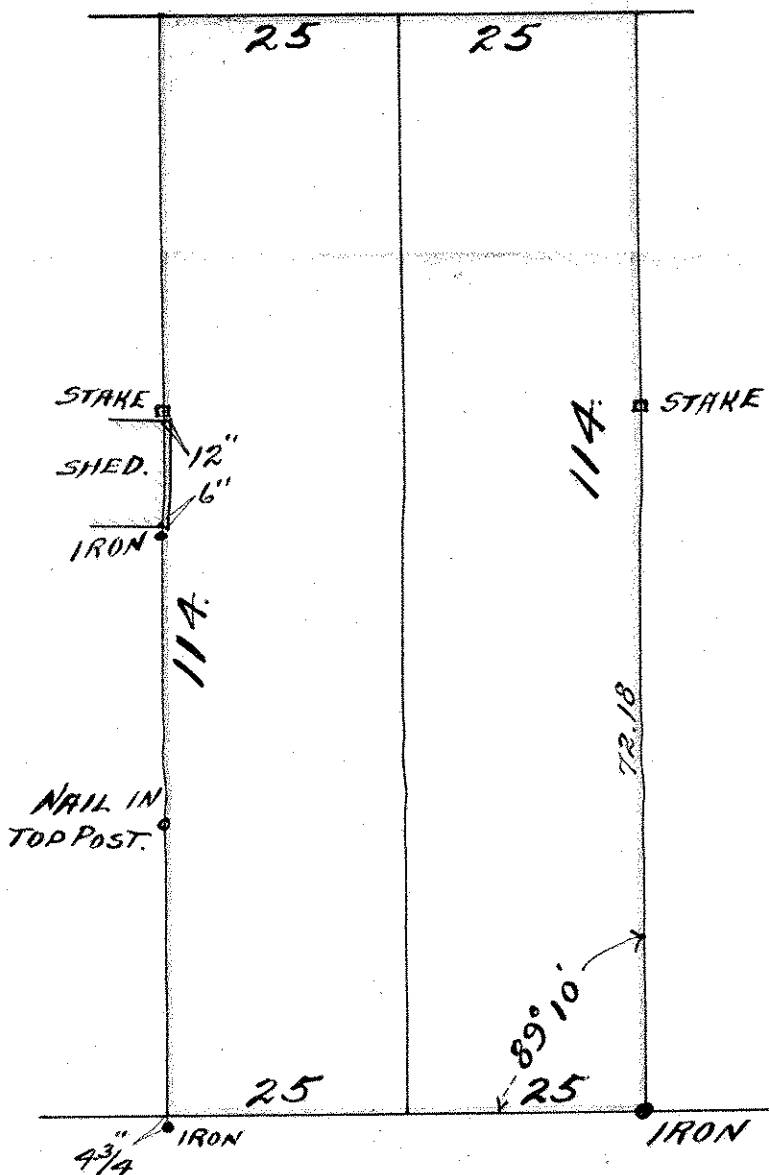

PAYNE AVE.